

UNITED STATES
DEPARTMENT OF THE INTERIOR
BUREAU OF LAND MANAGEMENT

RECEIVED
SEP 23 1983
WATER RESOURCES DEPT.
SALEM, OREGON


SECTION 3
NE 1/4 NE 1/4

Oregon State Water Filings

TOWNSHIP 38S., RANGE 2E., W. M.

Application No. R-66707, 66708

Permit No. R 9255 48170

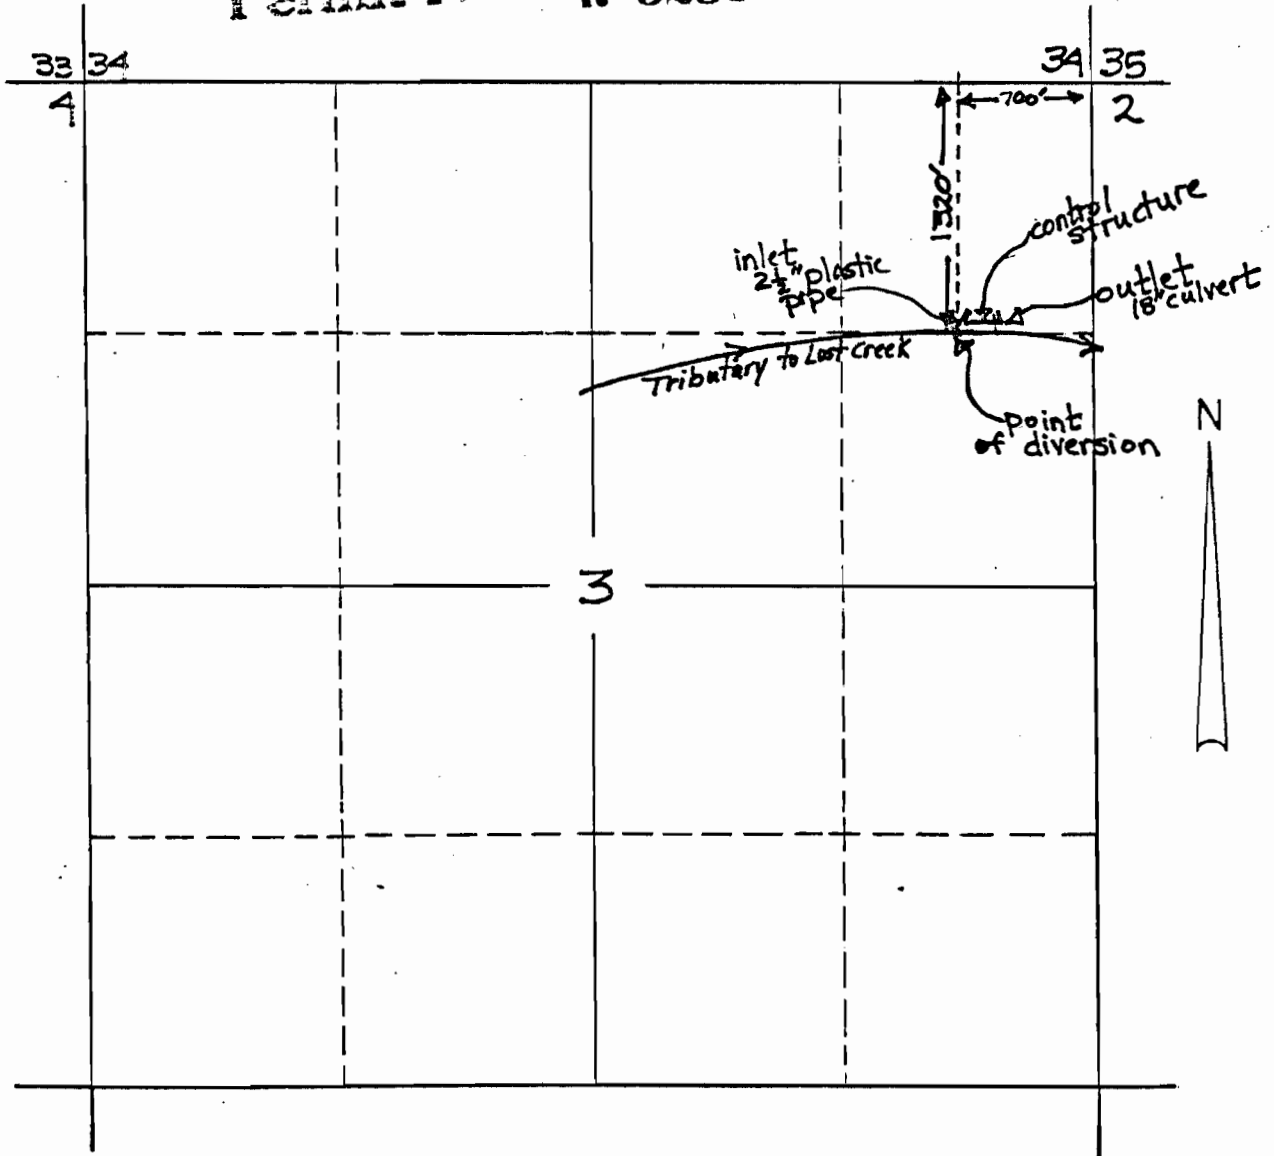

SCALE : 1" = 1000'