
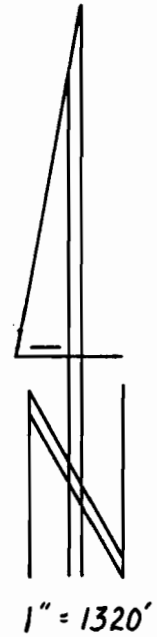


T. 6 S., R. 1 E., W.M.

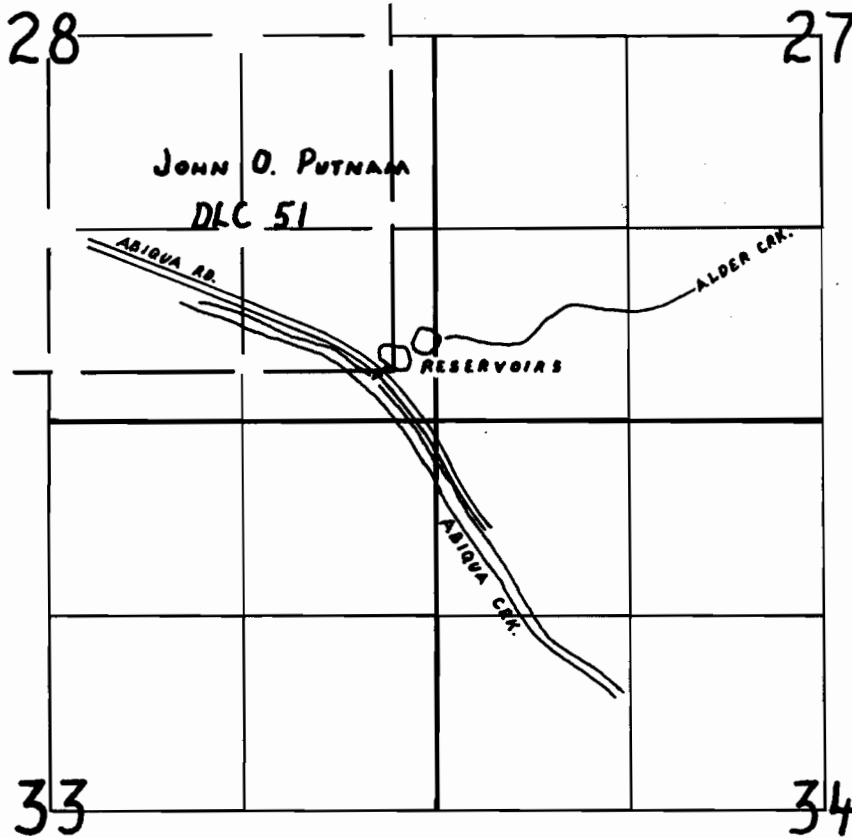

FINAL PROOF SURVEY

UNDER

Application No. ^{R-68008} 68009 Permit No. ^{R-9809} 48442
IN NAME OF

HELMUT FINK

Surveyed AUGUST 17, 1992, by R.W. Klassen