


T.2S. R.4E. W.M.

SCALE: 4" = 1 MILE

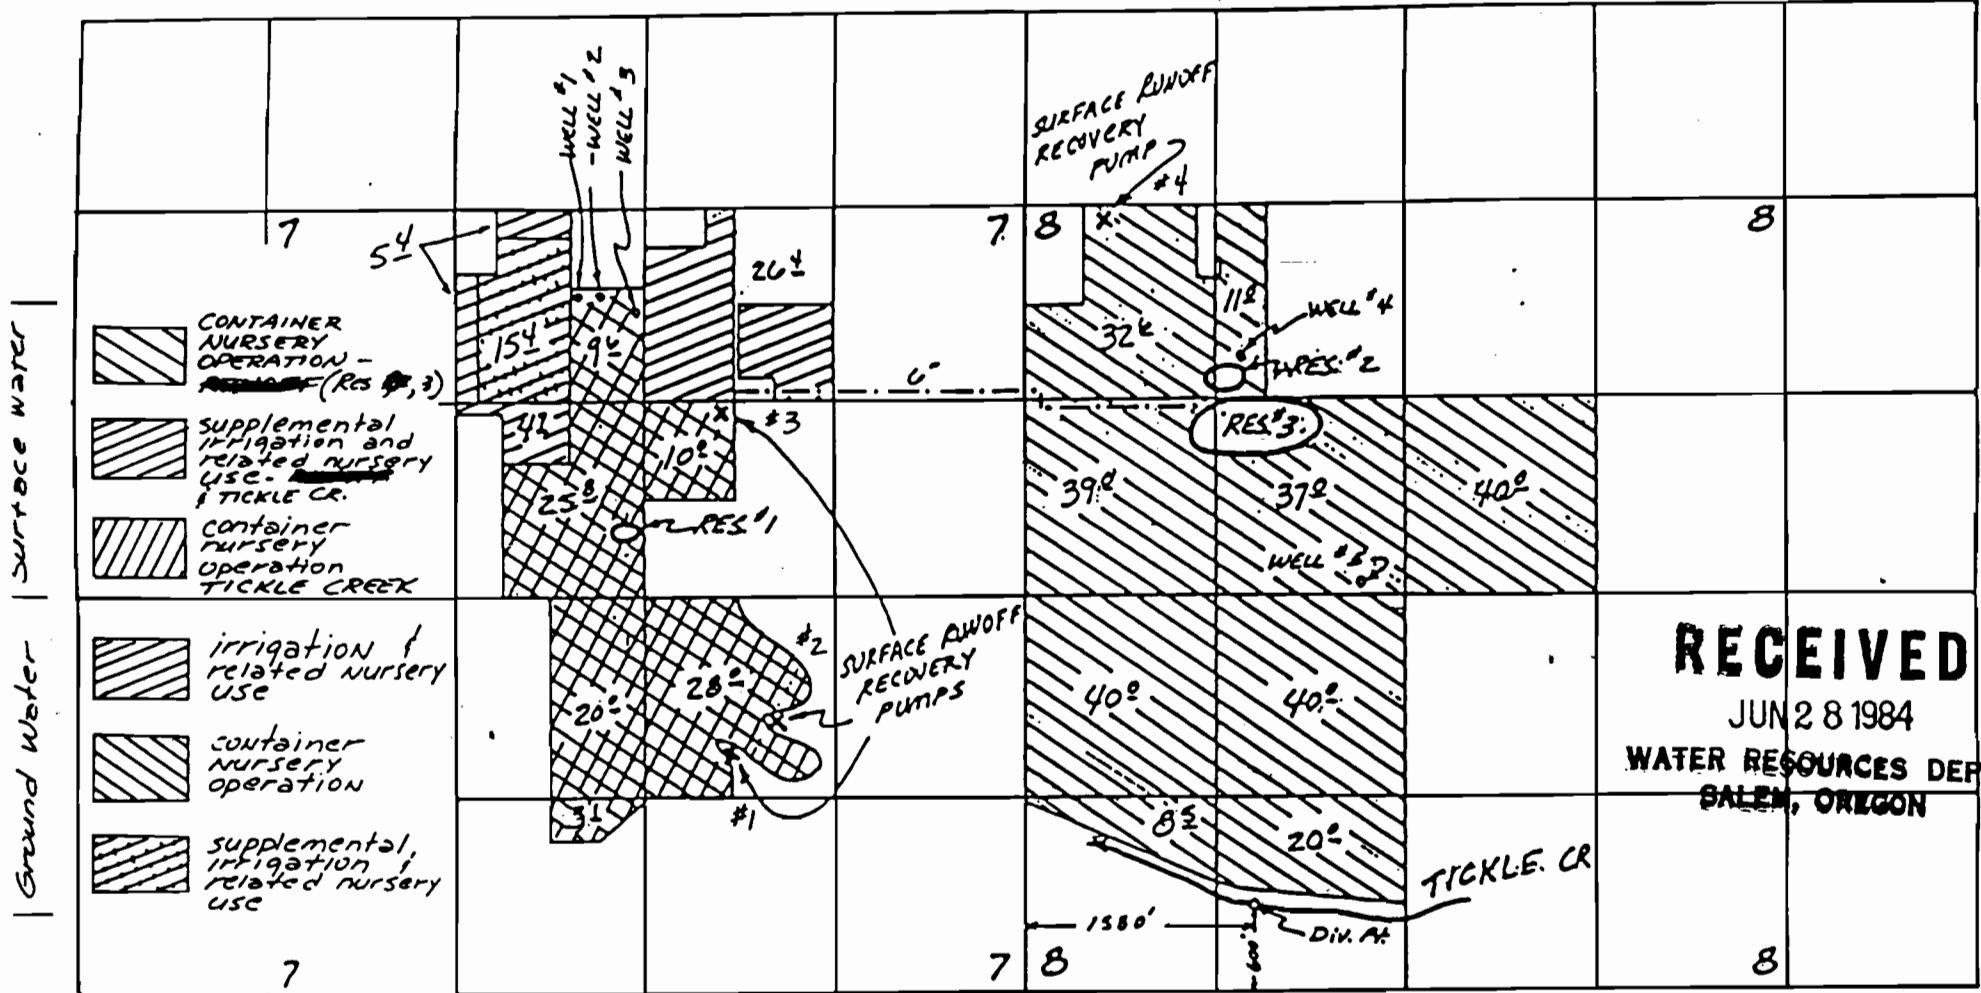

WELL LOCATIONS - WELL #1 600' S. | 850' E., WELL #2 600' S. | 1000' E., WELL #3 700' S. | 1260' E., ALL FROM THE N.W. COR. NE¼ NW¼ SEC 7, T2S, R4E
 WELL #4 1050' S. | 175' E. FROM THE N.W. COR. NE¼ NW¼ SEC. 8, T2S, R4E.
 WELL #5 50' N. | 300' W FROM THE CENTER SEC 8, T2S, R4E.

DIV. PTS LOCATIONS - TICKLE CR. 600' N. | 1500' E. FROM S.W. COR SEC 8, T2S, R4E.
 RES. #1 450' N. | 100' W. FROM CENTER SEC. 7, T2S, R4E.
 RES. #2 1400' N. | 1250' W. FROM CENTER SEC. 8, T2S, R4E.
 RES. #3 1200' N. | 1250' W. FROM CENTER SEC. 8, T2S, R4E.

THIS MAP PREPARED BY
 C.K. King
 ON INFORMATION FURNISHED BY
 THE APPLICANT

(4 Drainage ways)
 #1 SURFACE RUNOFF - 1050' S., 550' E }
 #2 SURFACE RUNOFF - 850' S., 900' E } All from center section 7, T2S, R4E
 #3 SURFACE RUNOFF - 1250' N., 525' E }
 #4 SURFACE RUNOFF - 100' S., 550' E from N.W. COR. section 8, T2S, R4E.

Application No. R-68128 & 68024
 Permit No. R 9901 48577

RECEIVED
 JUN 28 1984
 WATER RESOURCES DEPT
 SALEM, OREGON