


Section 35 T.16S. R.3W.W.M.

16 03 3

LANE COUNTY

SCALE 1"=400'

See Map 16 03 26

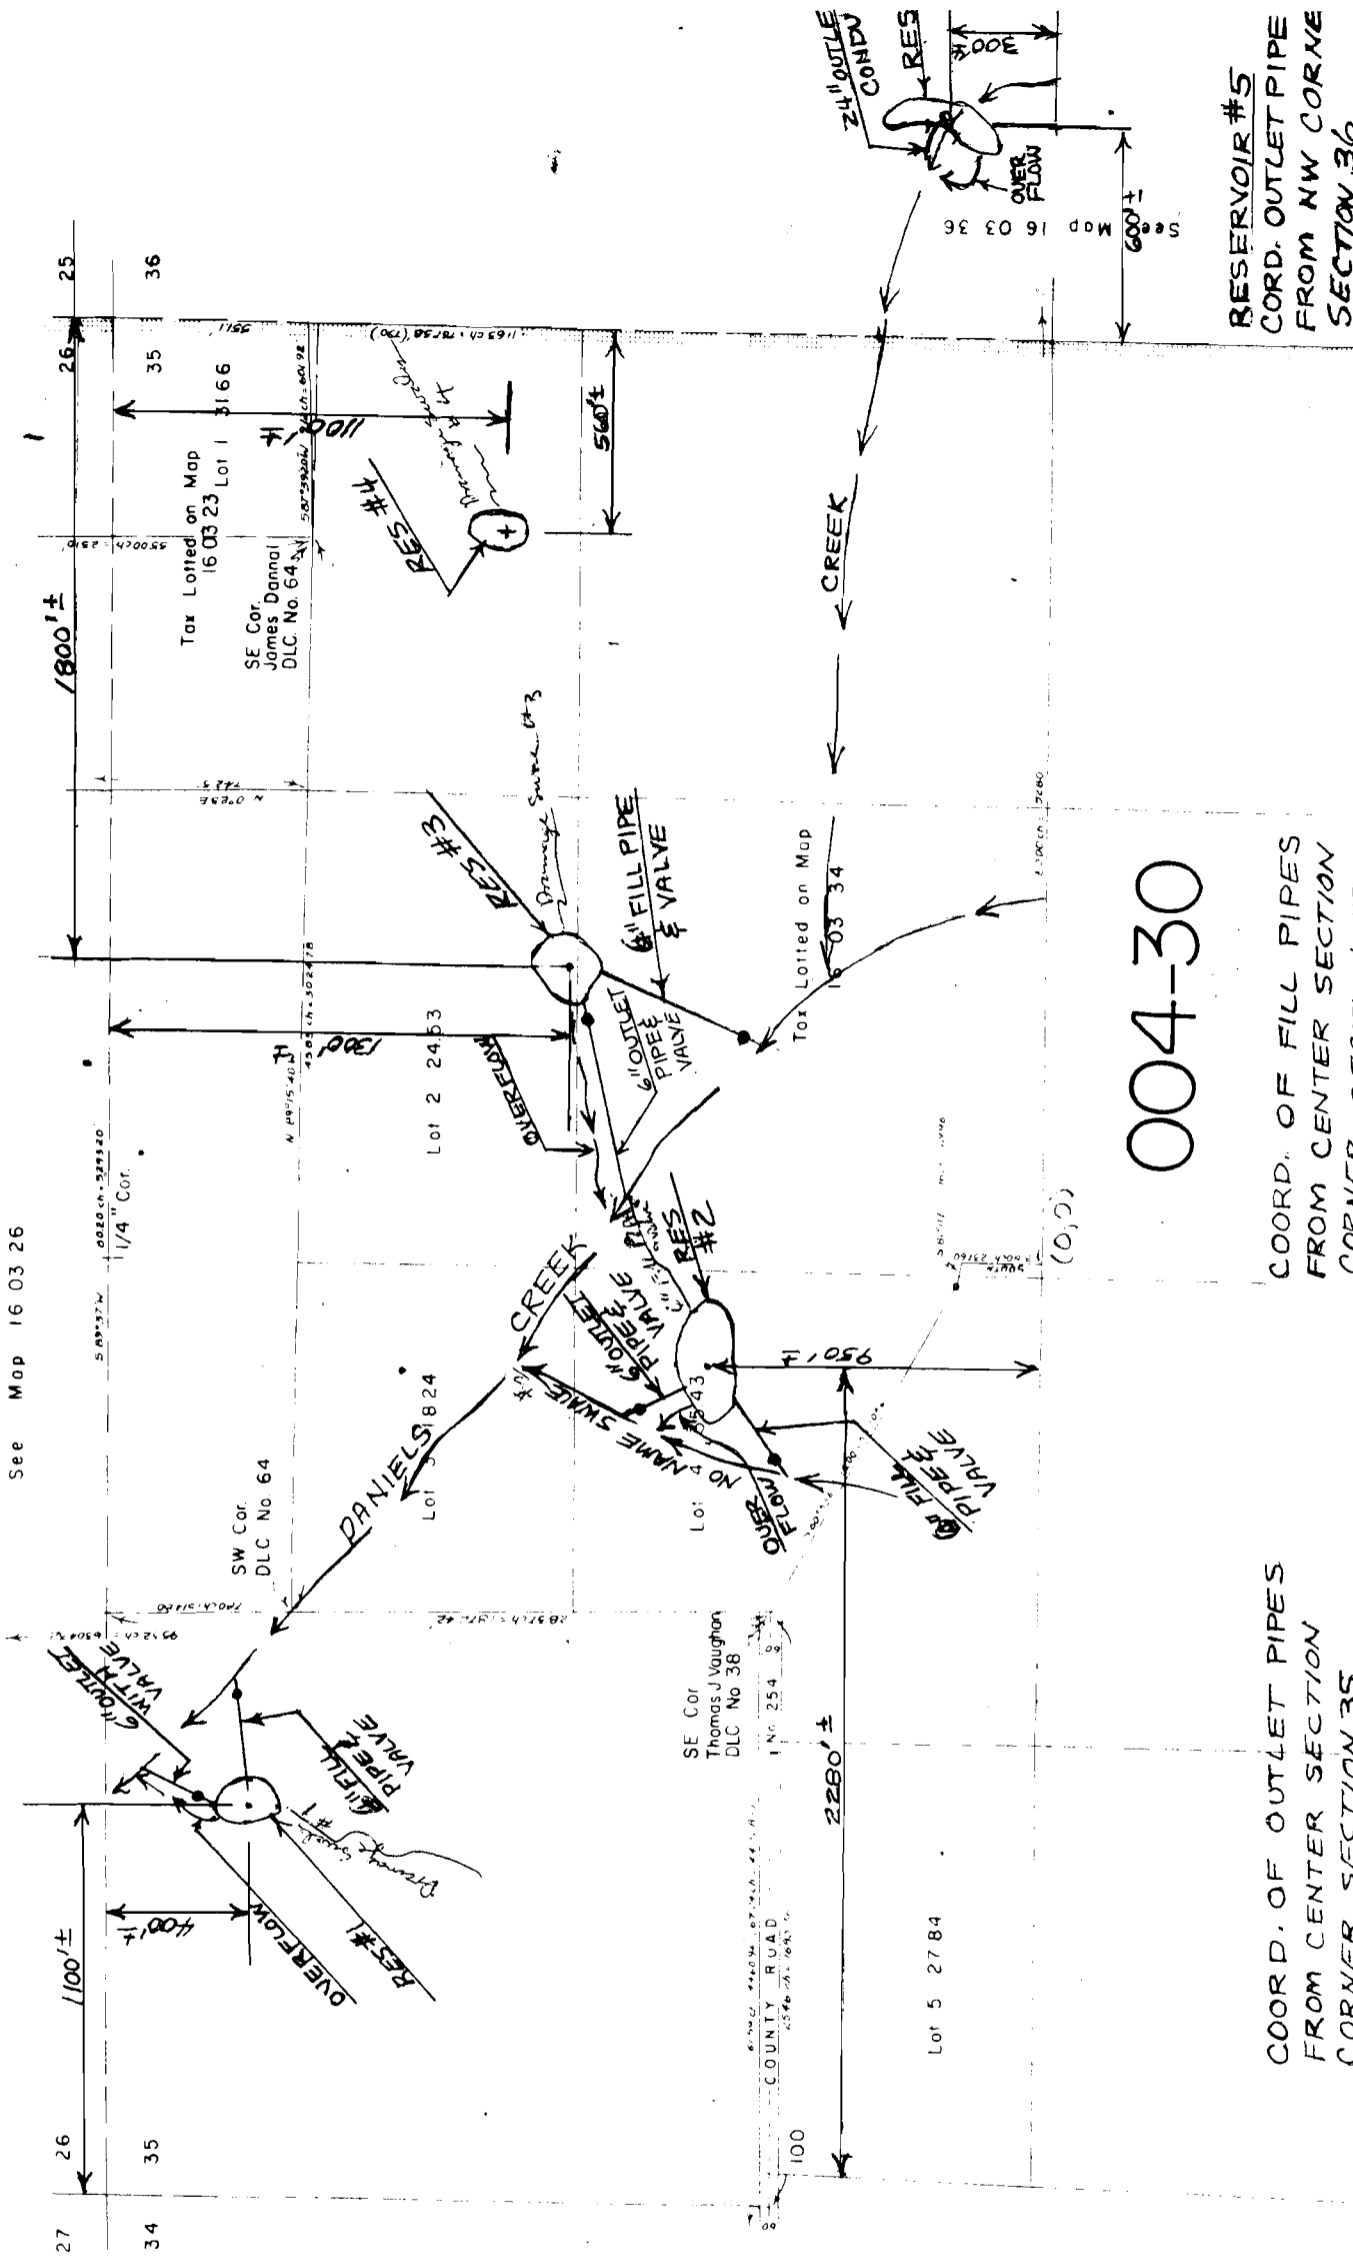

See Map 16 03 34

004-30

COORD. OF OUTLET PIPES FROM CENTER SECTION CORNER SECTION 35

COORD. OF FILL PIPES FROM CENTER SECTION CORNER SECTION 36

RESERVOIR #5  
CORD. OUTLET PIPE FROM NW CORNER SECTION 36