


SECTION

TOWNSHIP 25S, RANGE 13W, W. M.

North

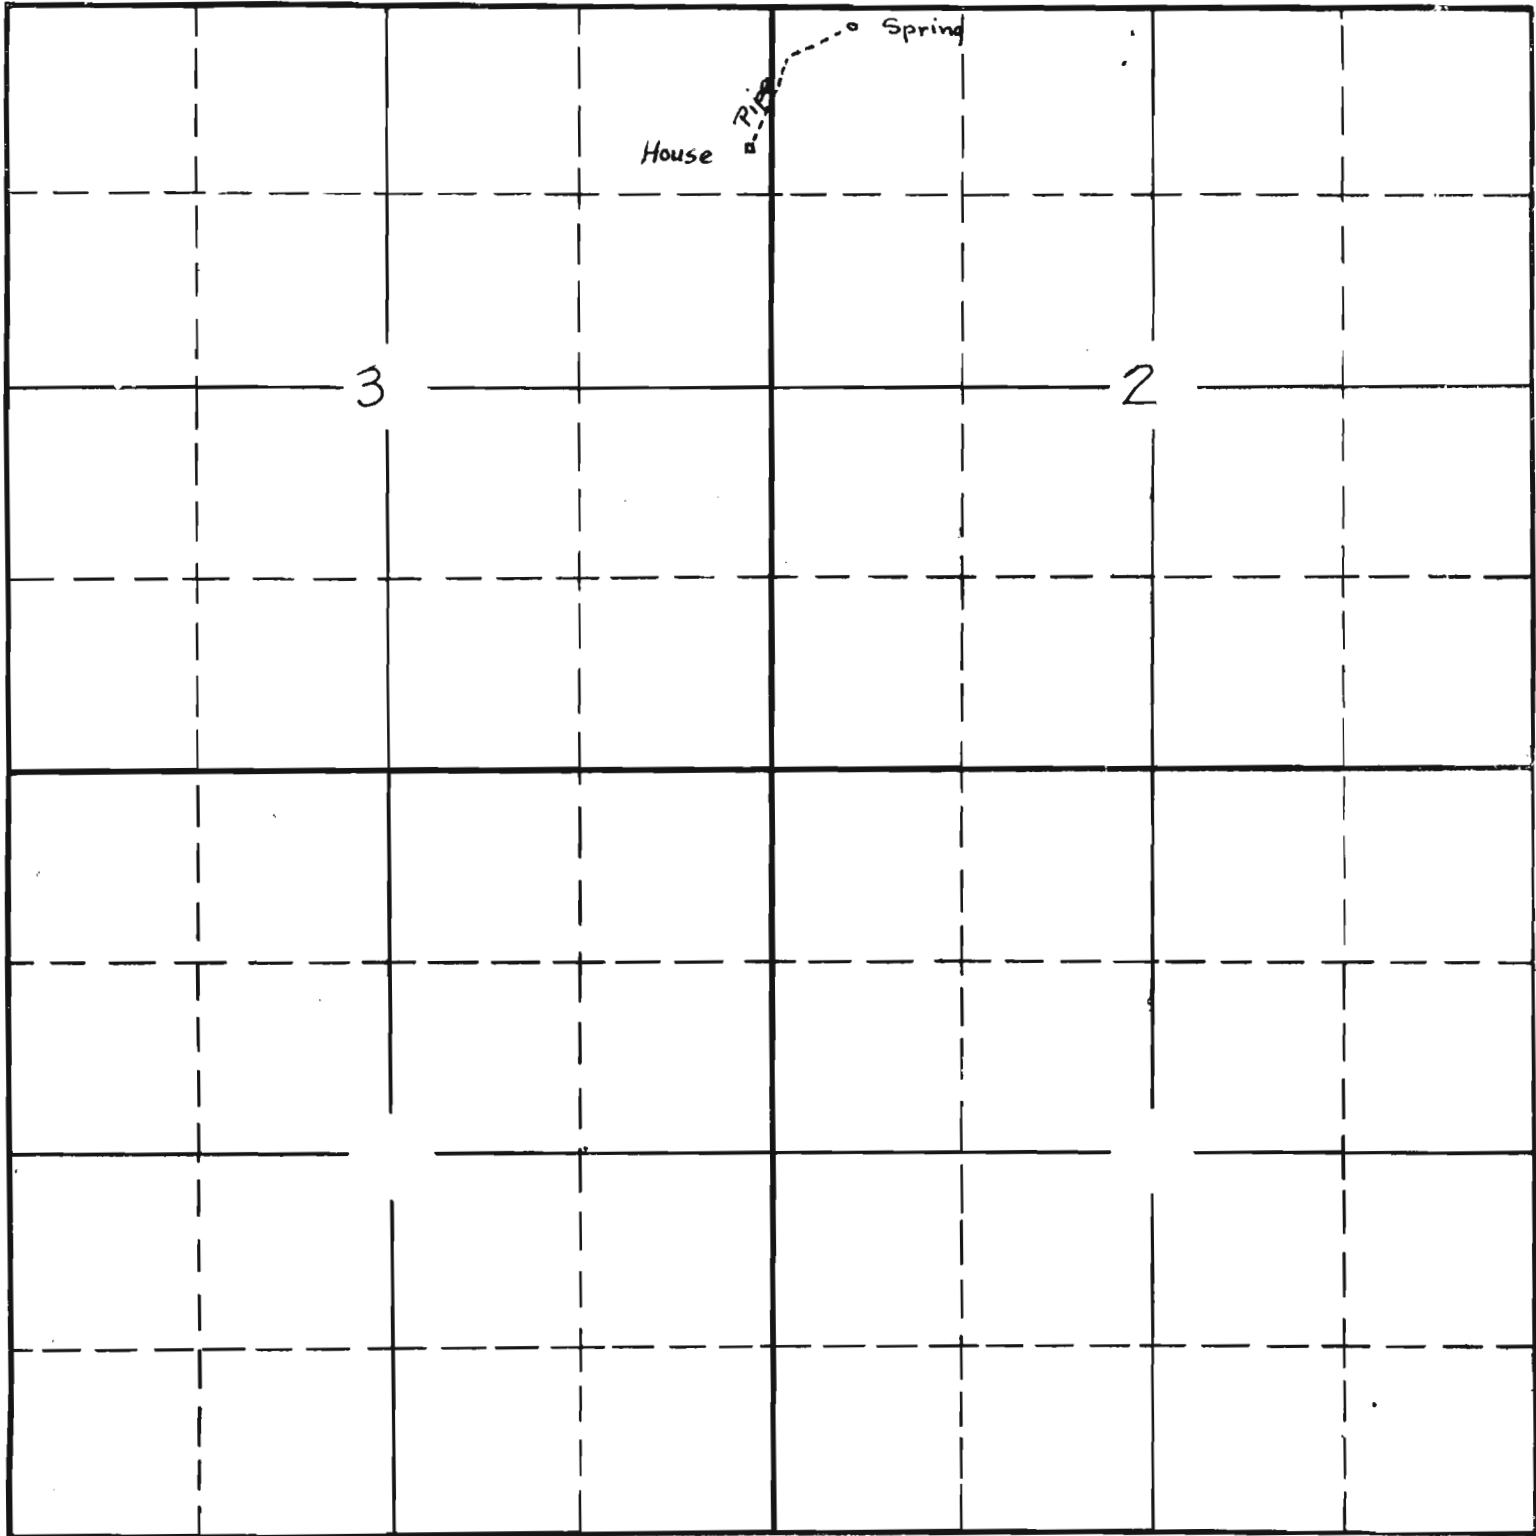

South

APPLICATION No. 13898
PERMIT No. 10004