

SECTION


\_\_\_\_\_

\_\_\_\_\_

\_\_\_\_\_

TOWNSHIP 75, RANGE 3W, W. M.

North

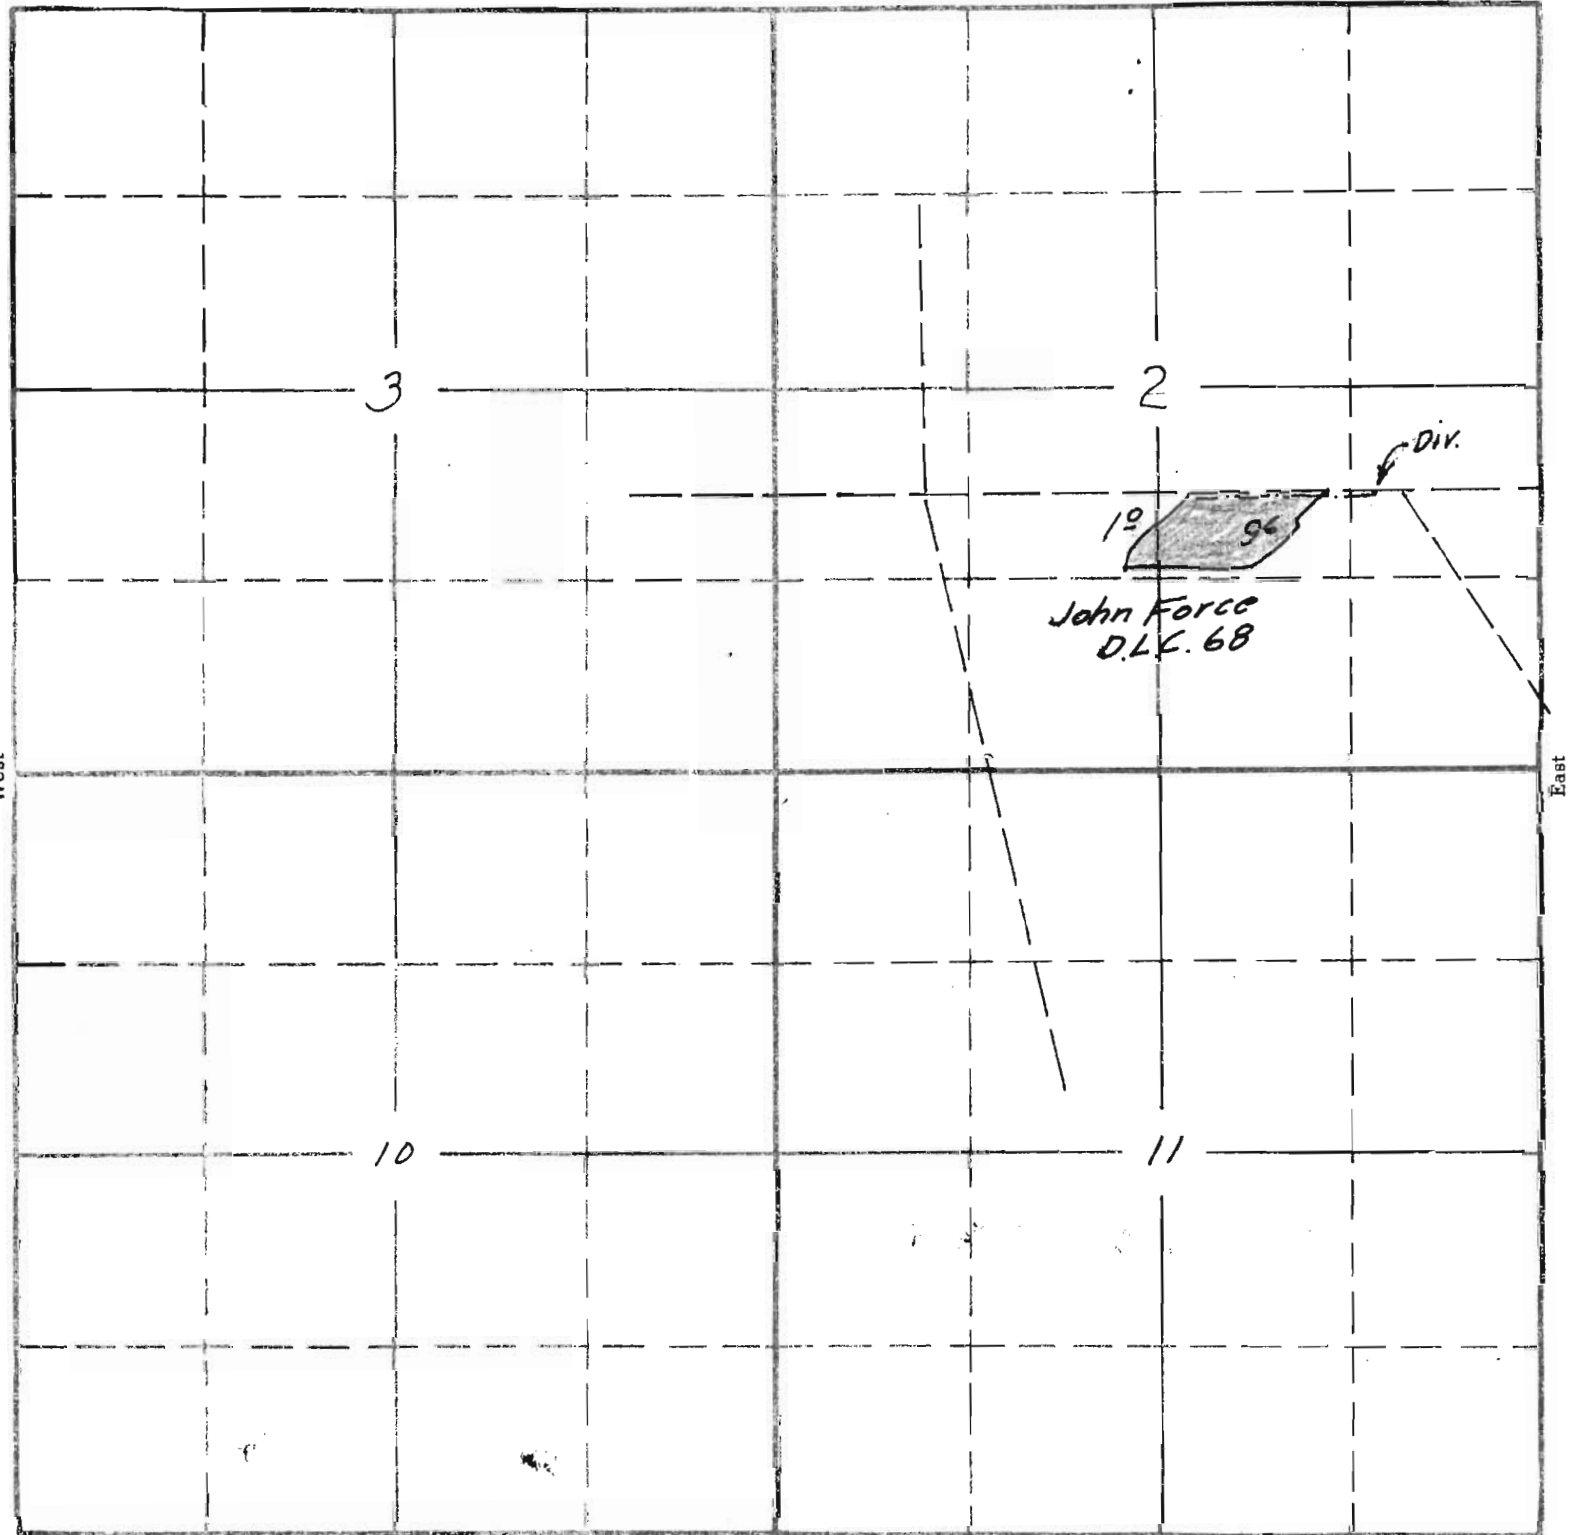

*Surveyed May 22 1940 C.C.C.*

South


APPLICATION No. 13913  
PERMIT No. 10012

SECTION

2

TOWNSHIP 7S., RANGE 3W., W. M.

North

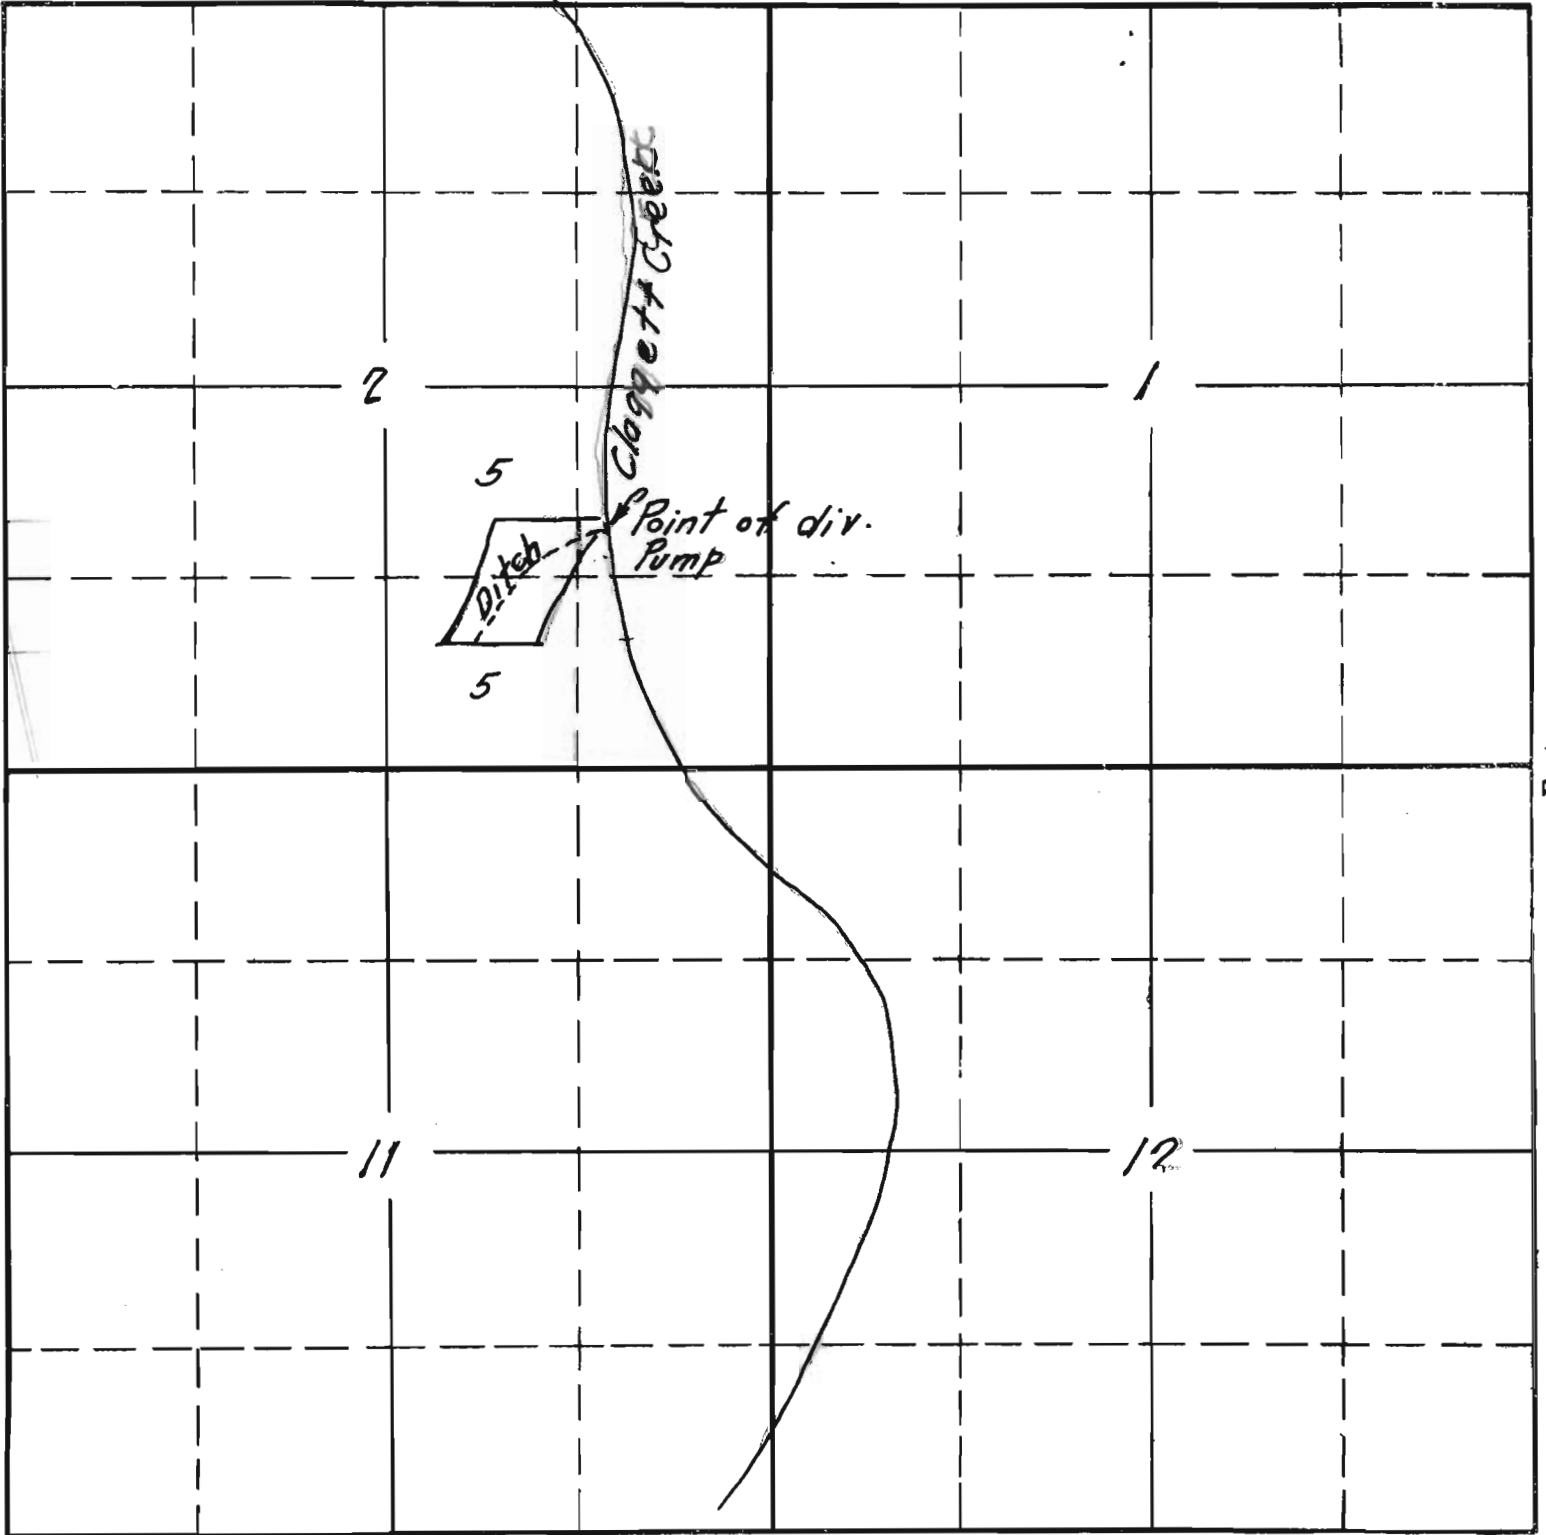

South

APPLICATION No. 13913  
PERMIT No. 10012