


SECTION

TOWNSHIP 15, RANGE 3 E, W. M.

North

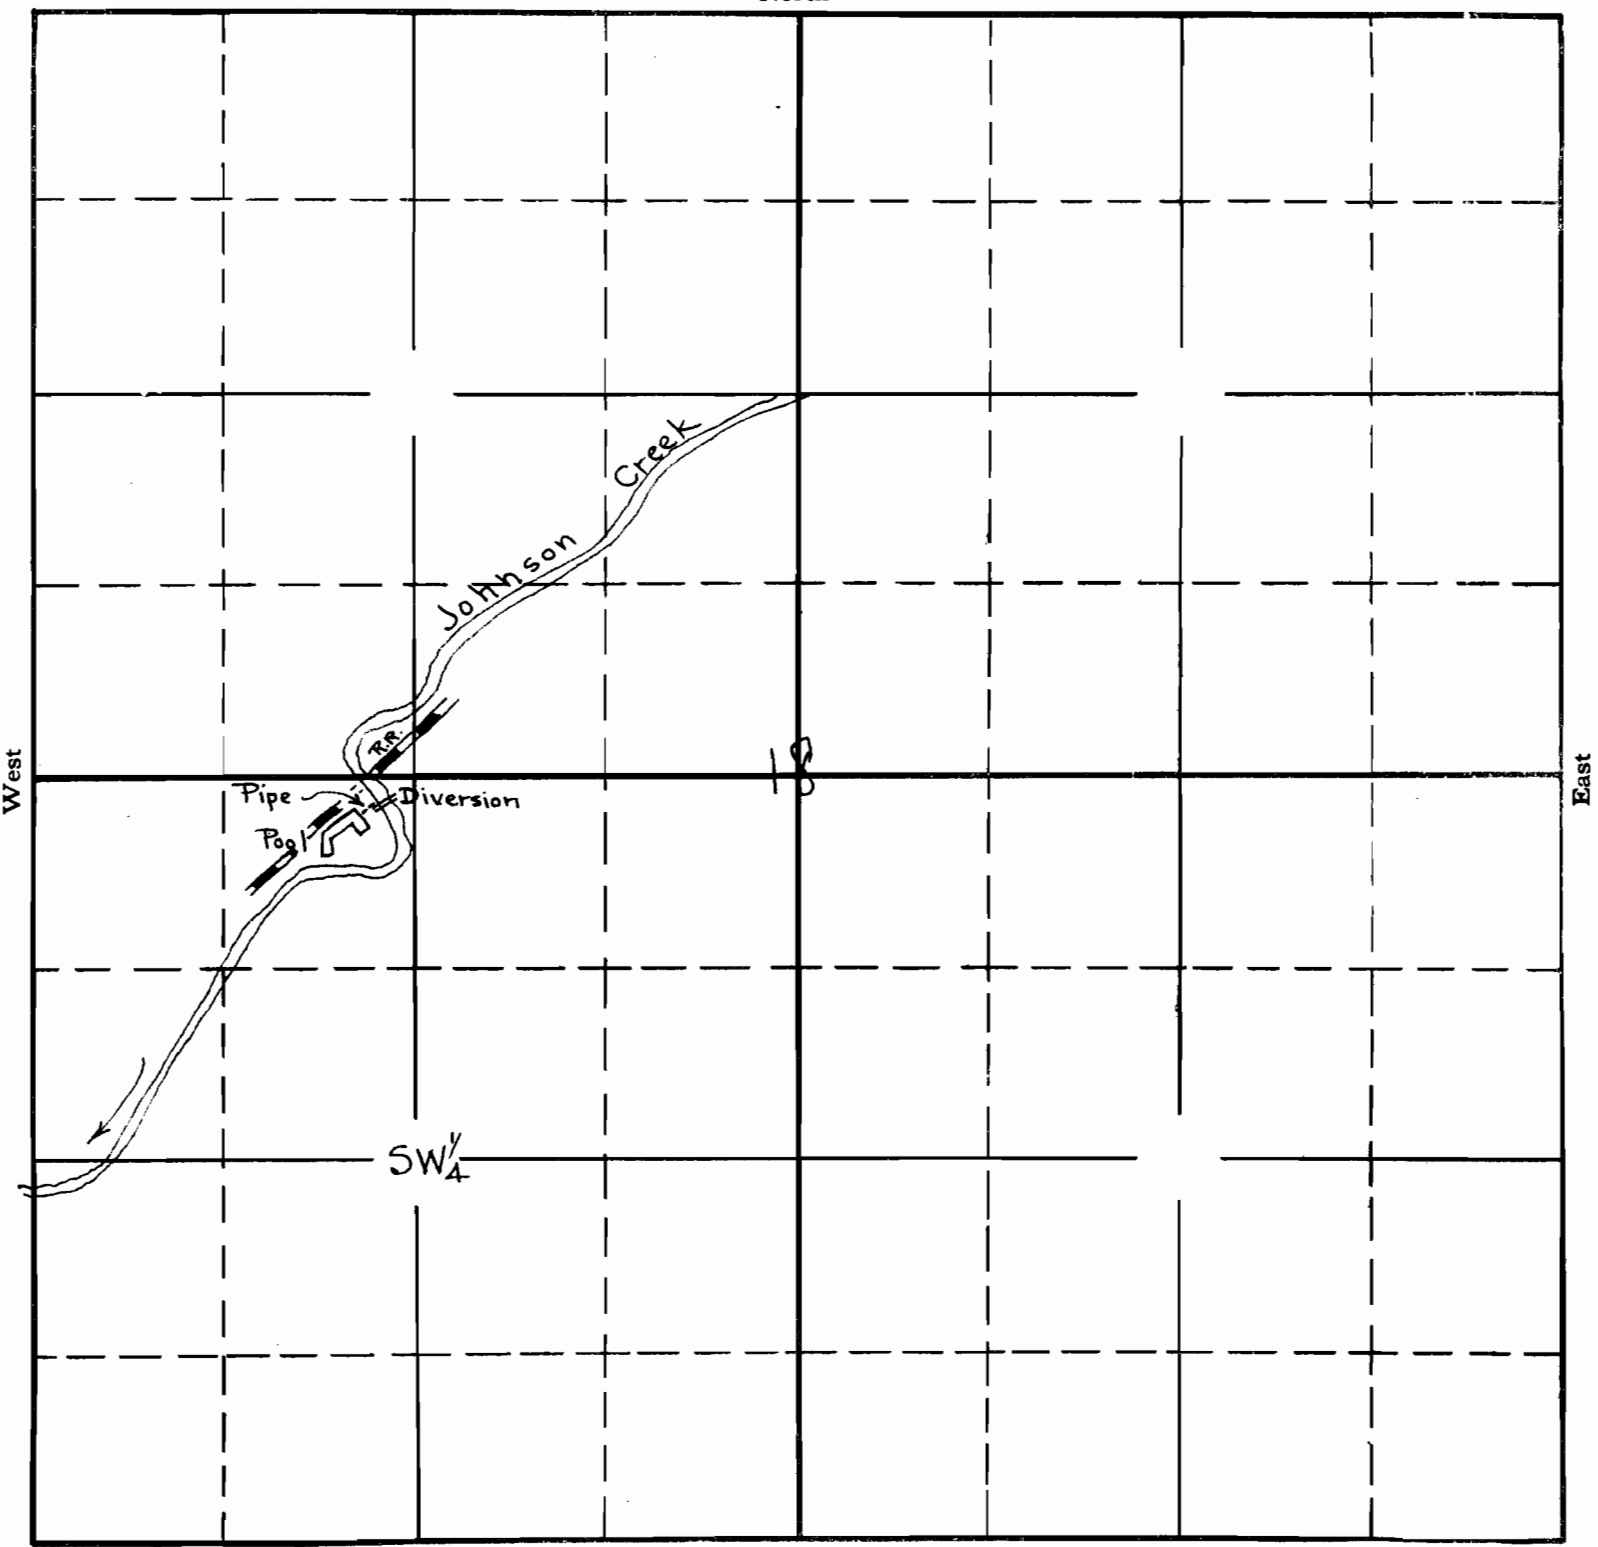

South

APPLICATION No. 13940
 PERMIT No. 10027