


Amended Map
 To accompany
 Application No. 13883
 Permit No. 10034

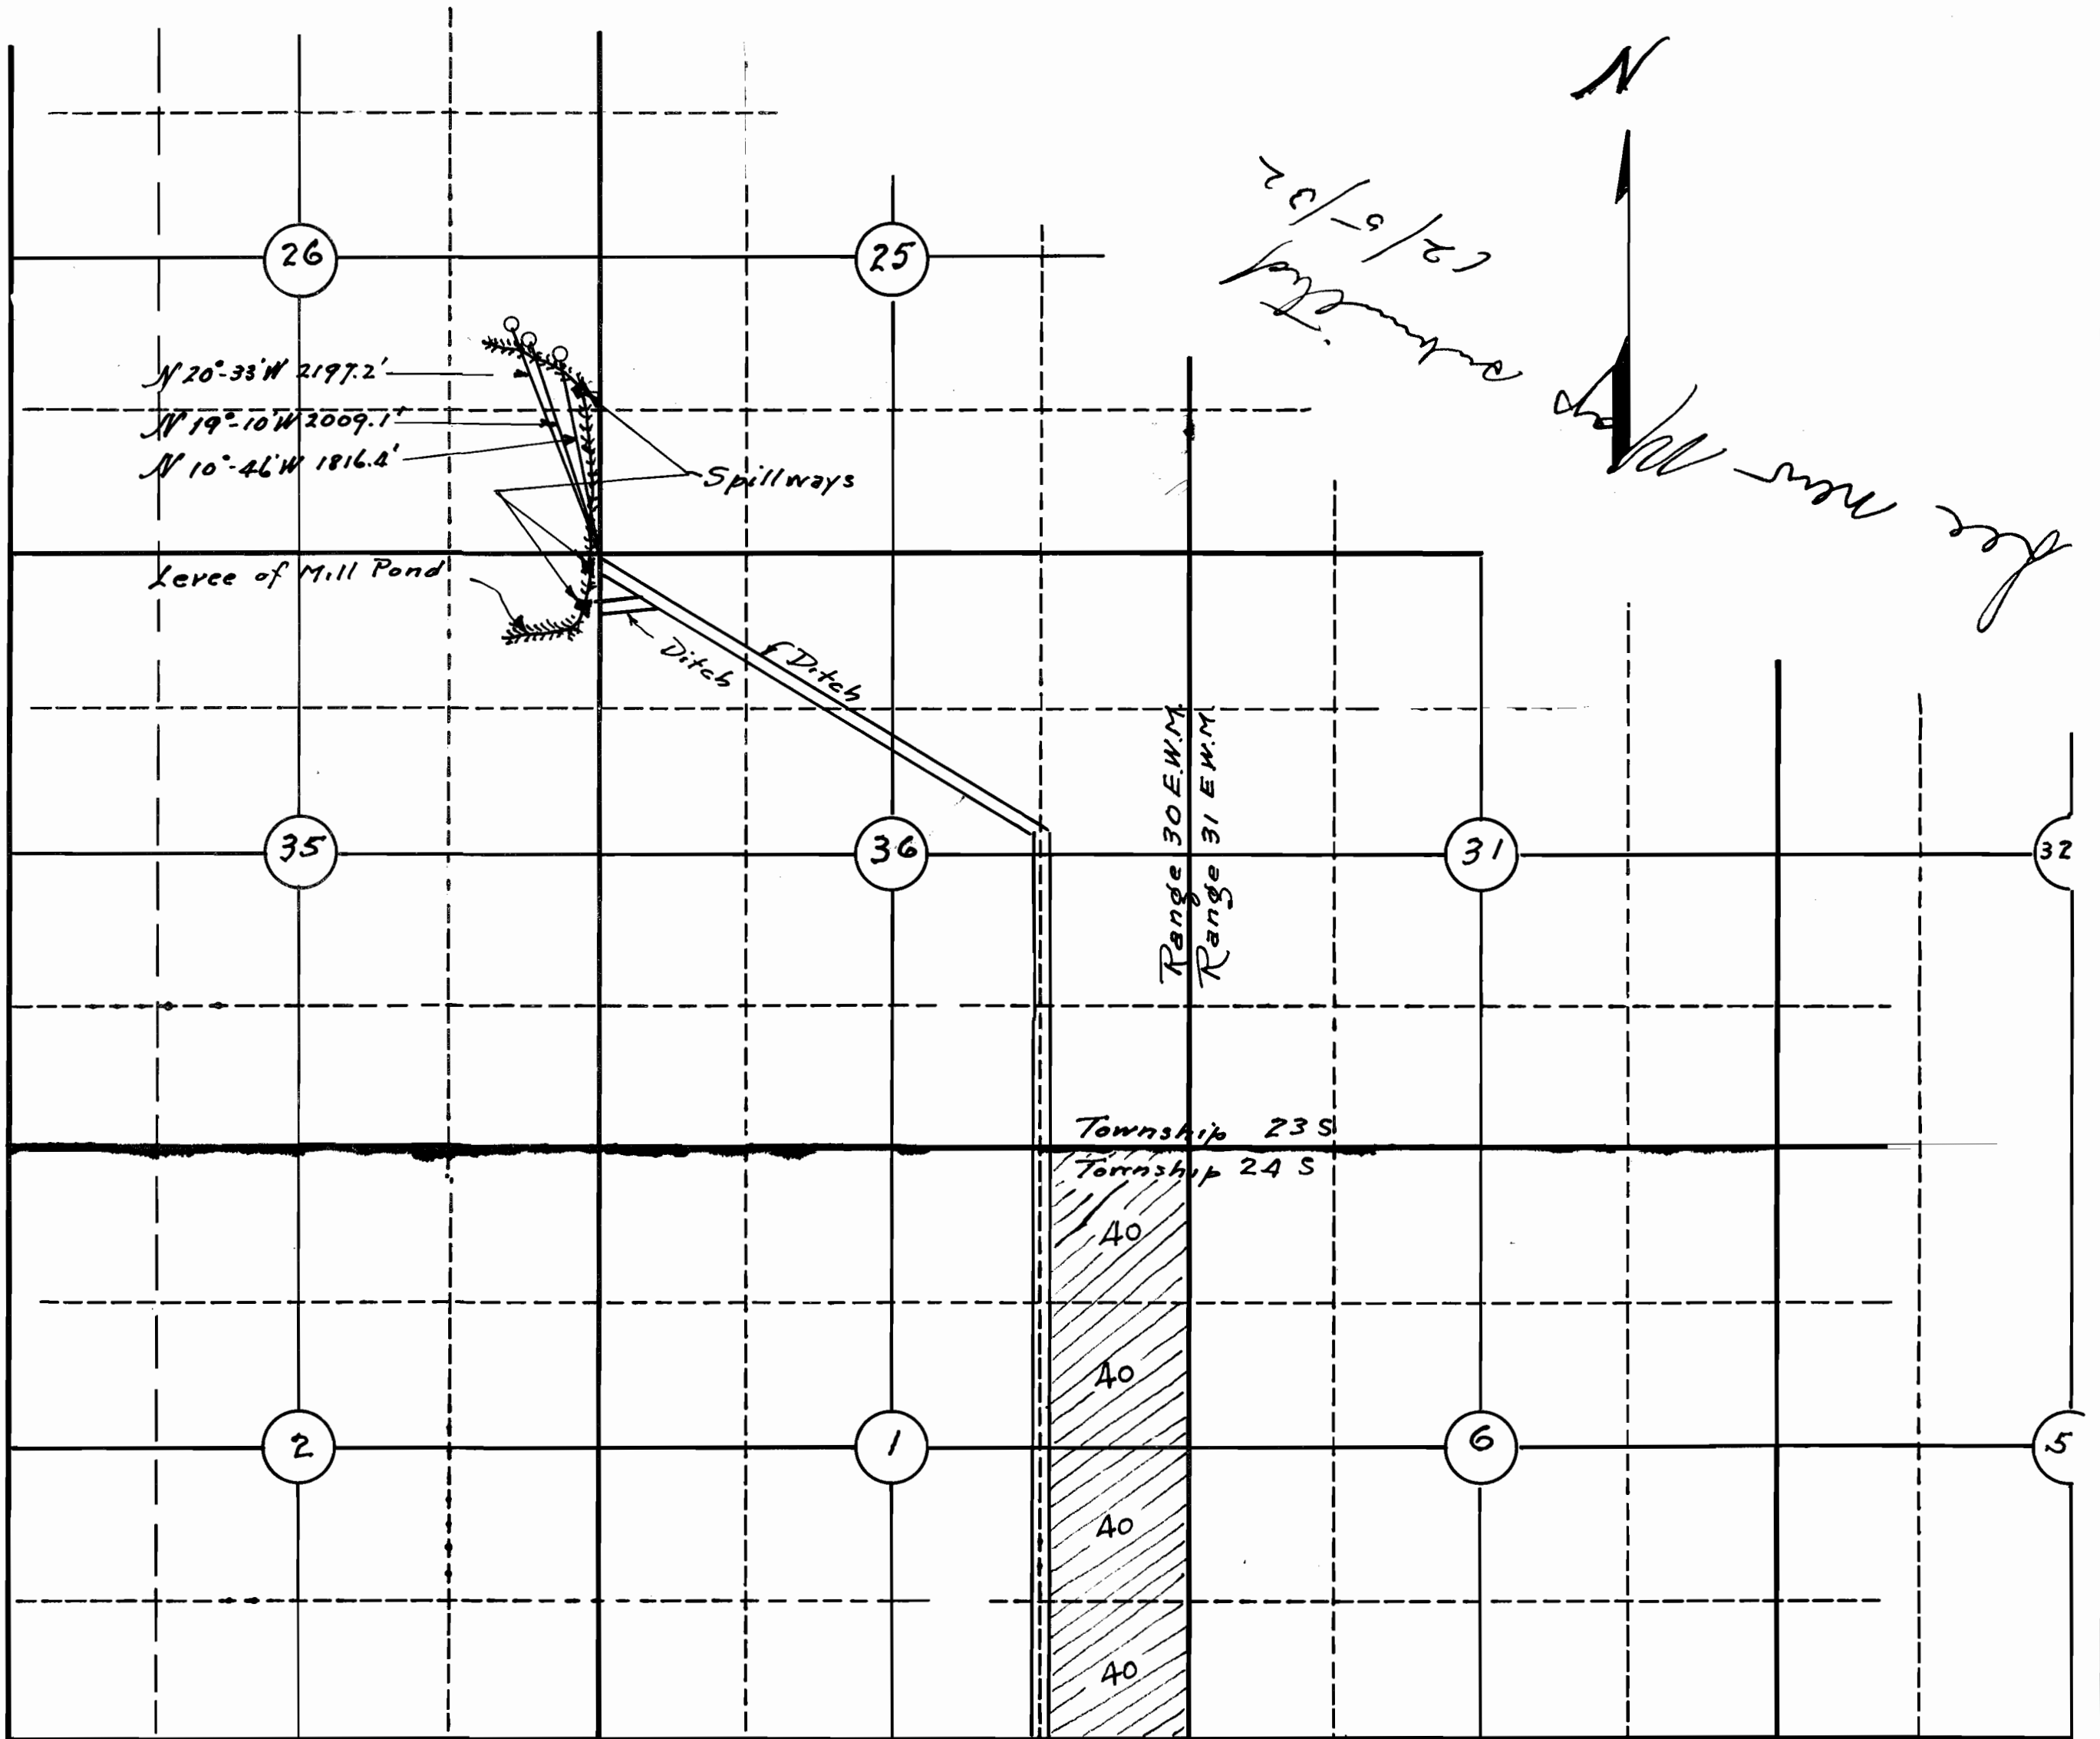

$N 20^{\circ} 33' W 2197.2'$
 $N 19^{\circ} 10' W 2009.1'$
 $N 10^{\circ} 46' W 1816.2'$

Spillways

Levee of Mill Pond

Ditch

Range 30 E.W.M.
Range 31 E.W.M.

Township 23 S
Township 24 S

40
40
40
40

for new map

N
for new map

Application No. 13883
Permit No. 10034