


SECTION

12

TOWNSHIP 6, RANGE 8, W. M.

North

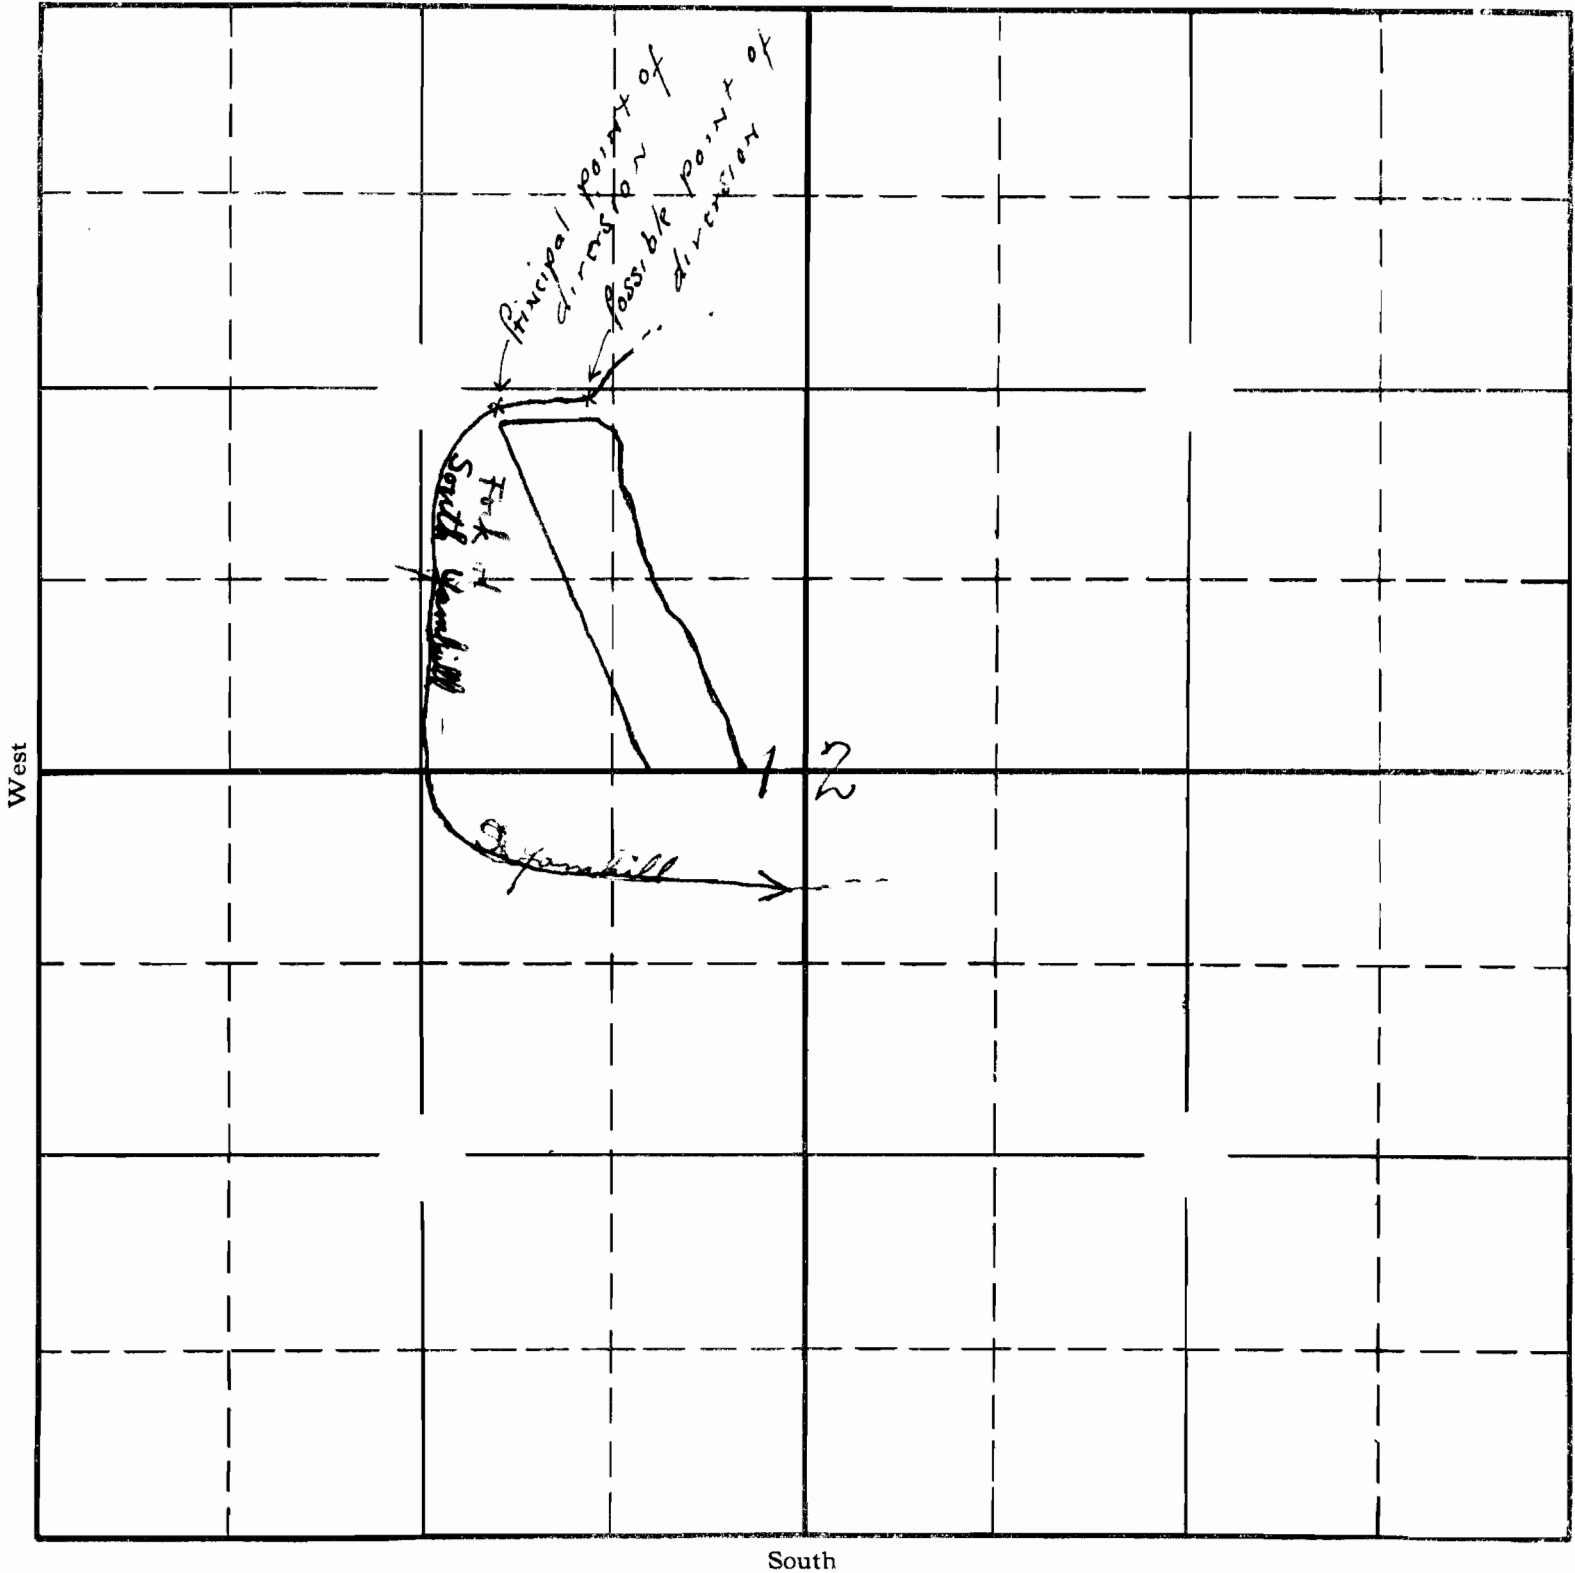

South

APPLICATION No. 13958  
PERMIT No. 10056