


SECTION

TOWNSHIP 1 N., RANGE 3 W., W. M.

North

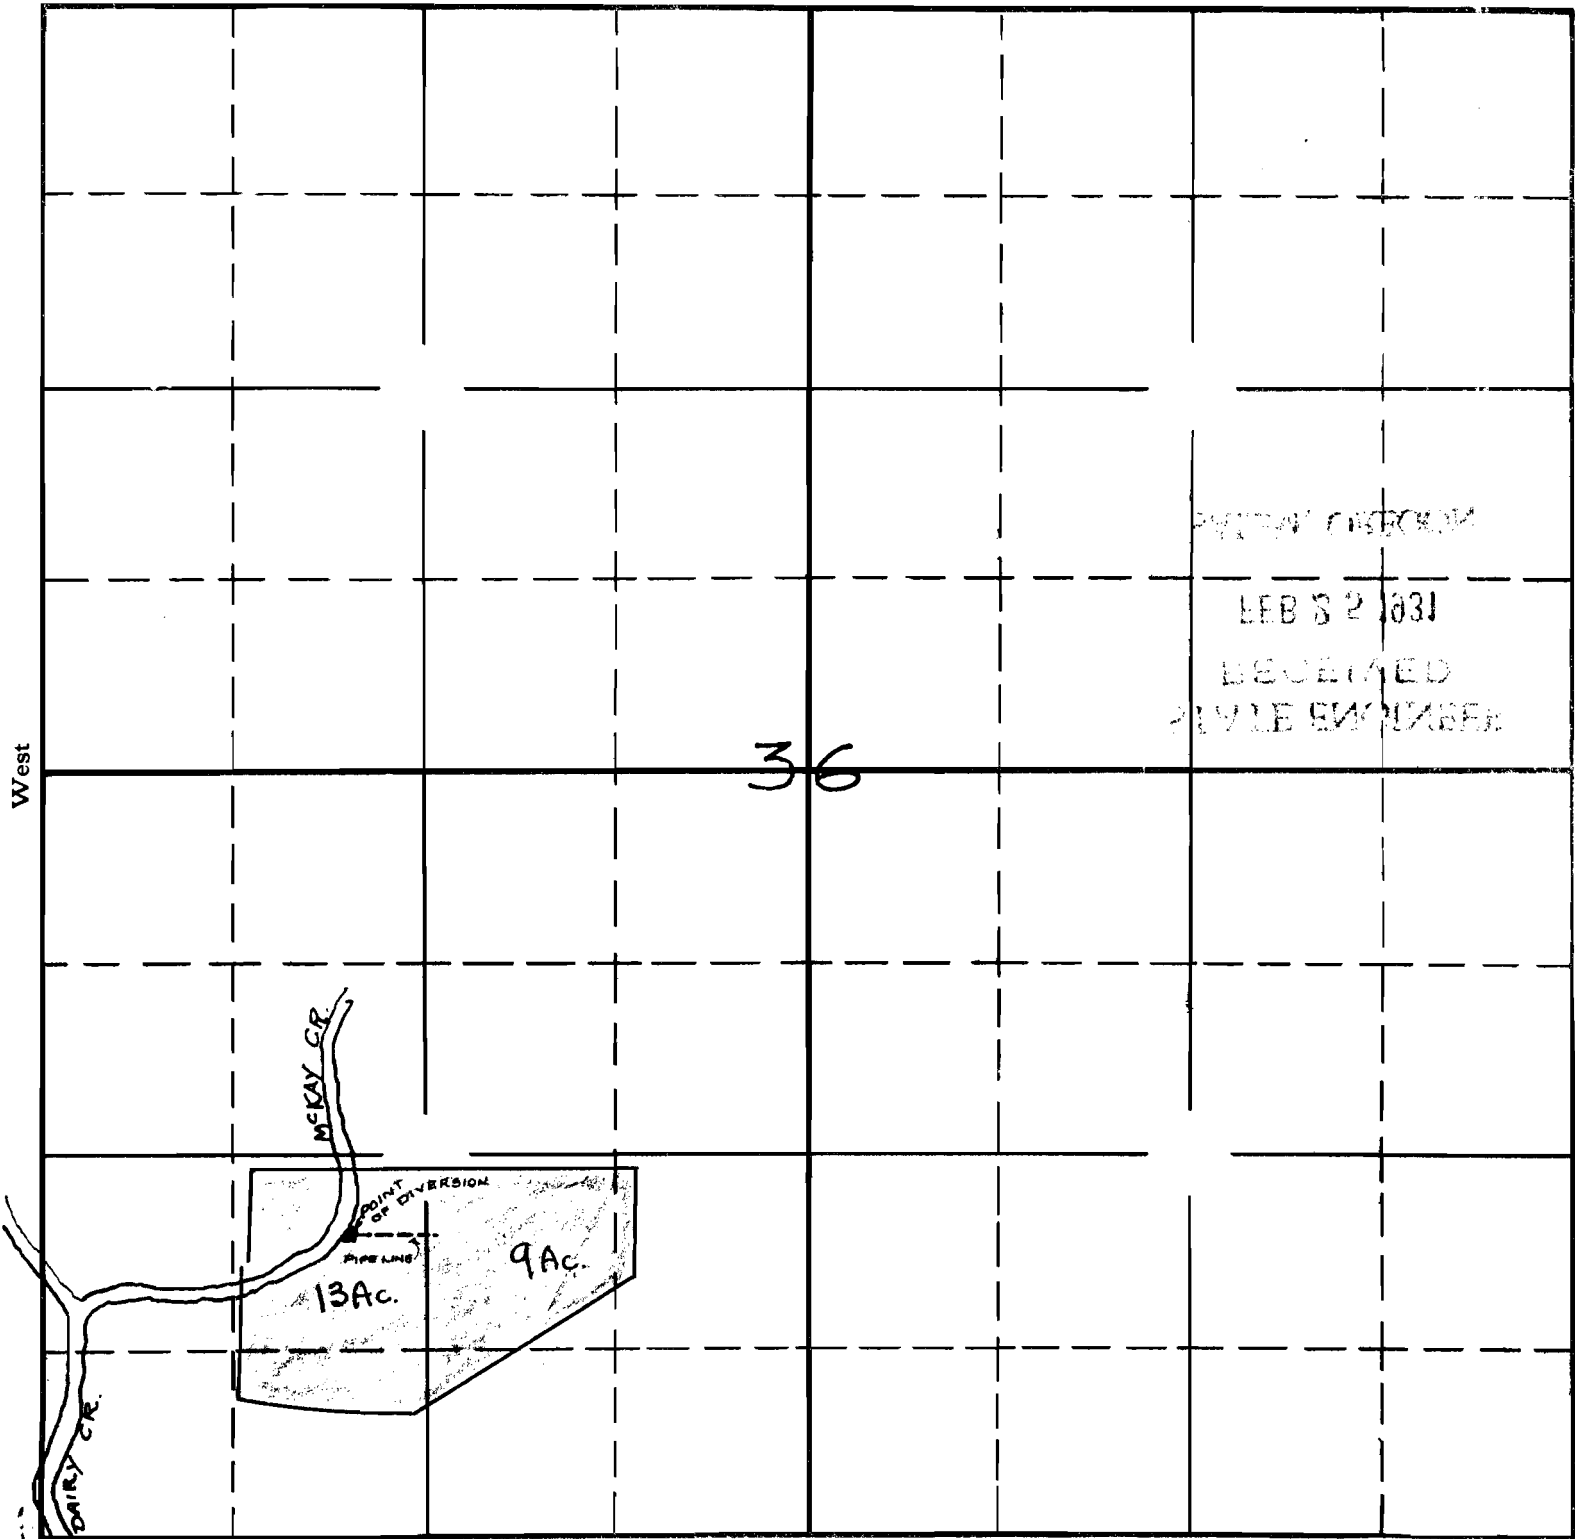

South

APPLICATION No. 13968
PERMIT No. 10064