


SECTION

TOWNSHIP 2 N, RANGE 15 E, W. M.

North

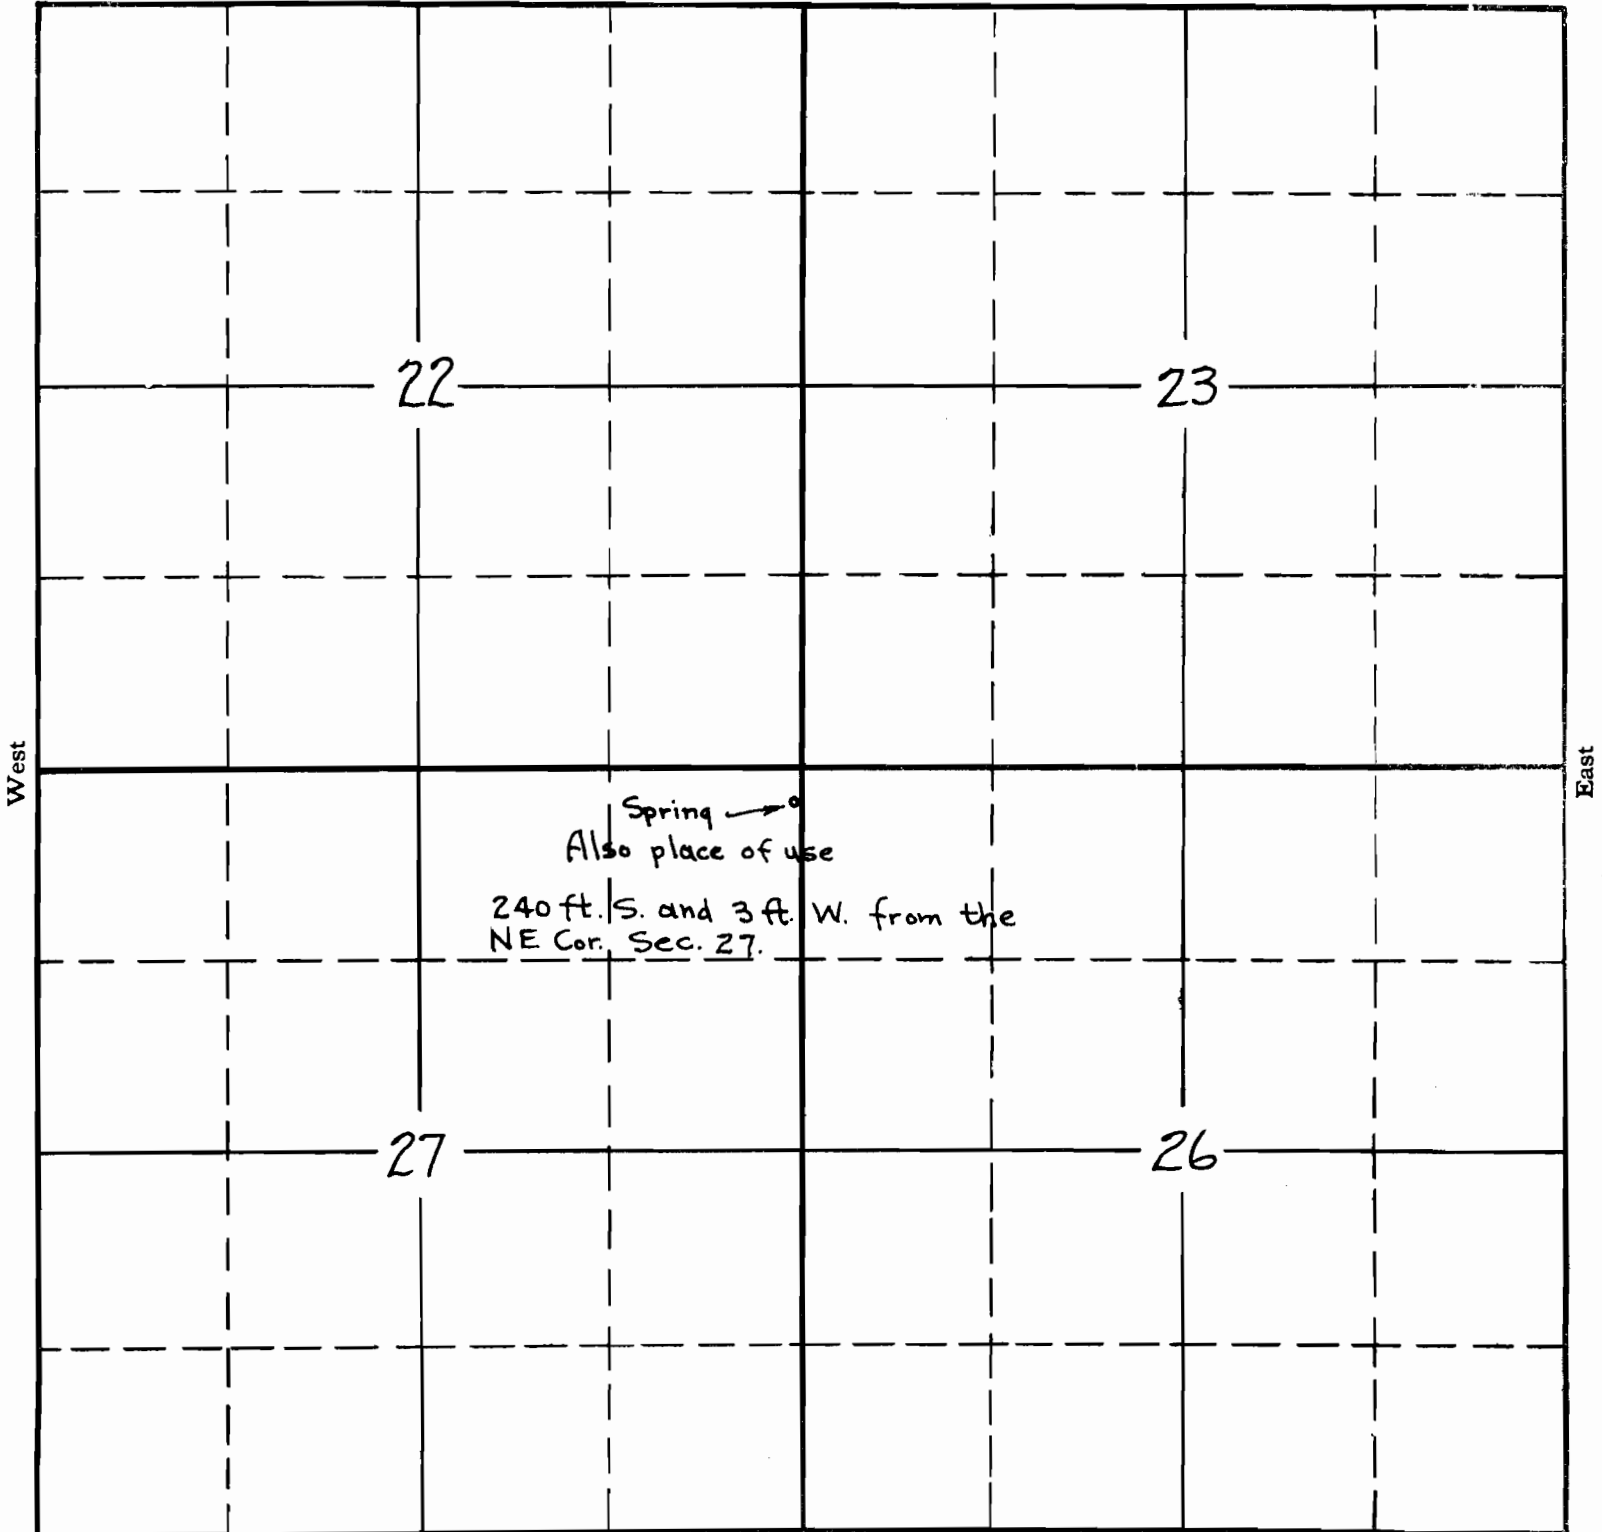

South

APPLICATION No. 13977
PERMIT No. 10070