


SECTION
5
6
7
8

TOWNSHIP 29S, RANGE 4W; W. M.

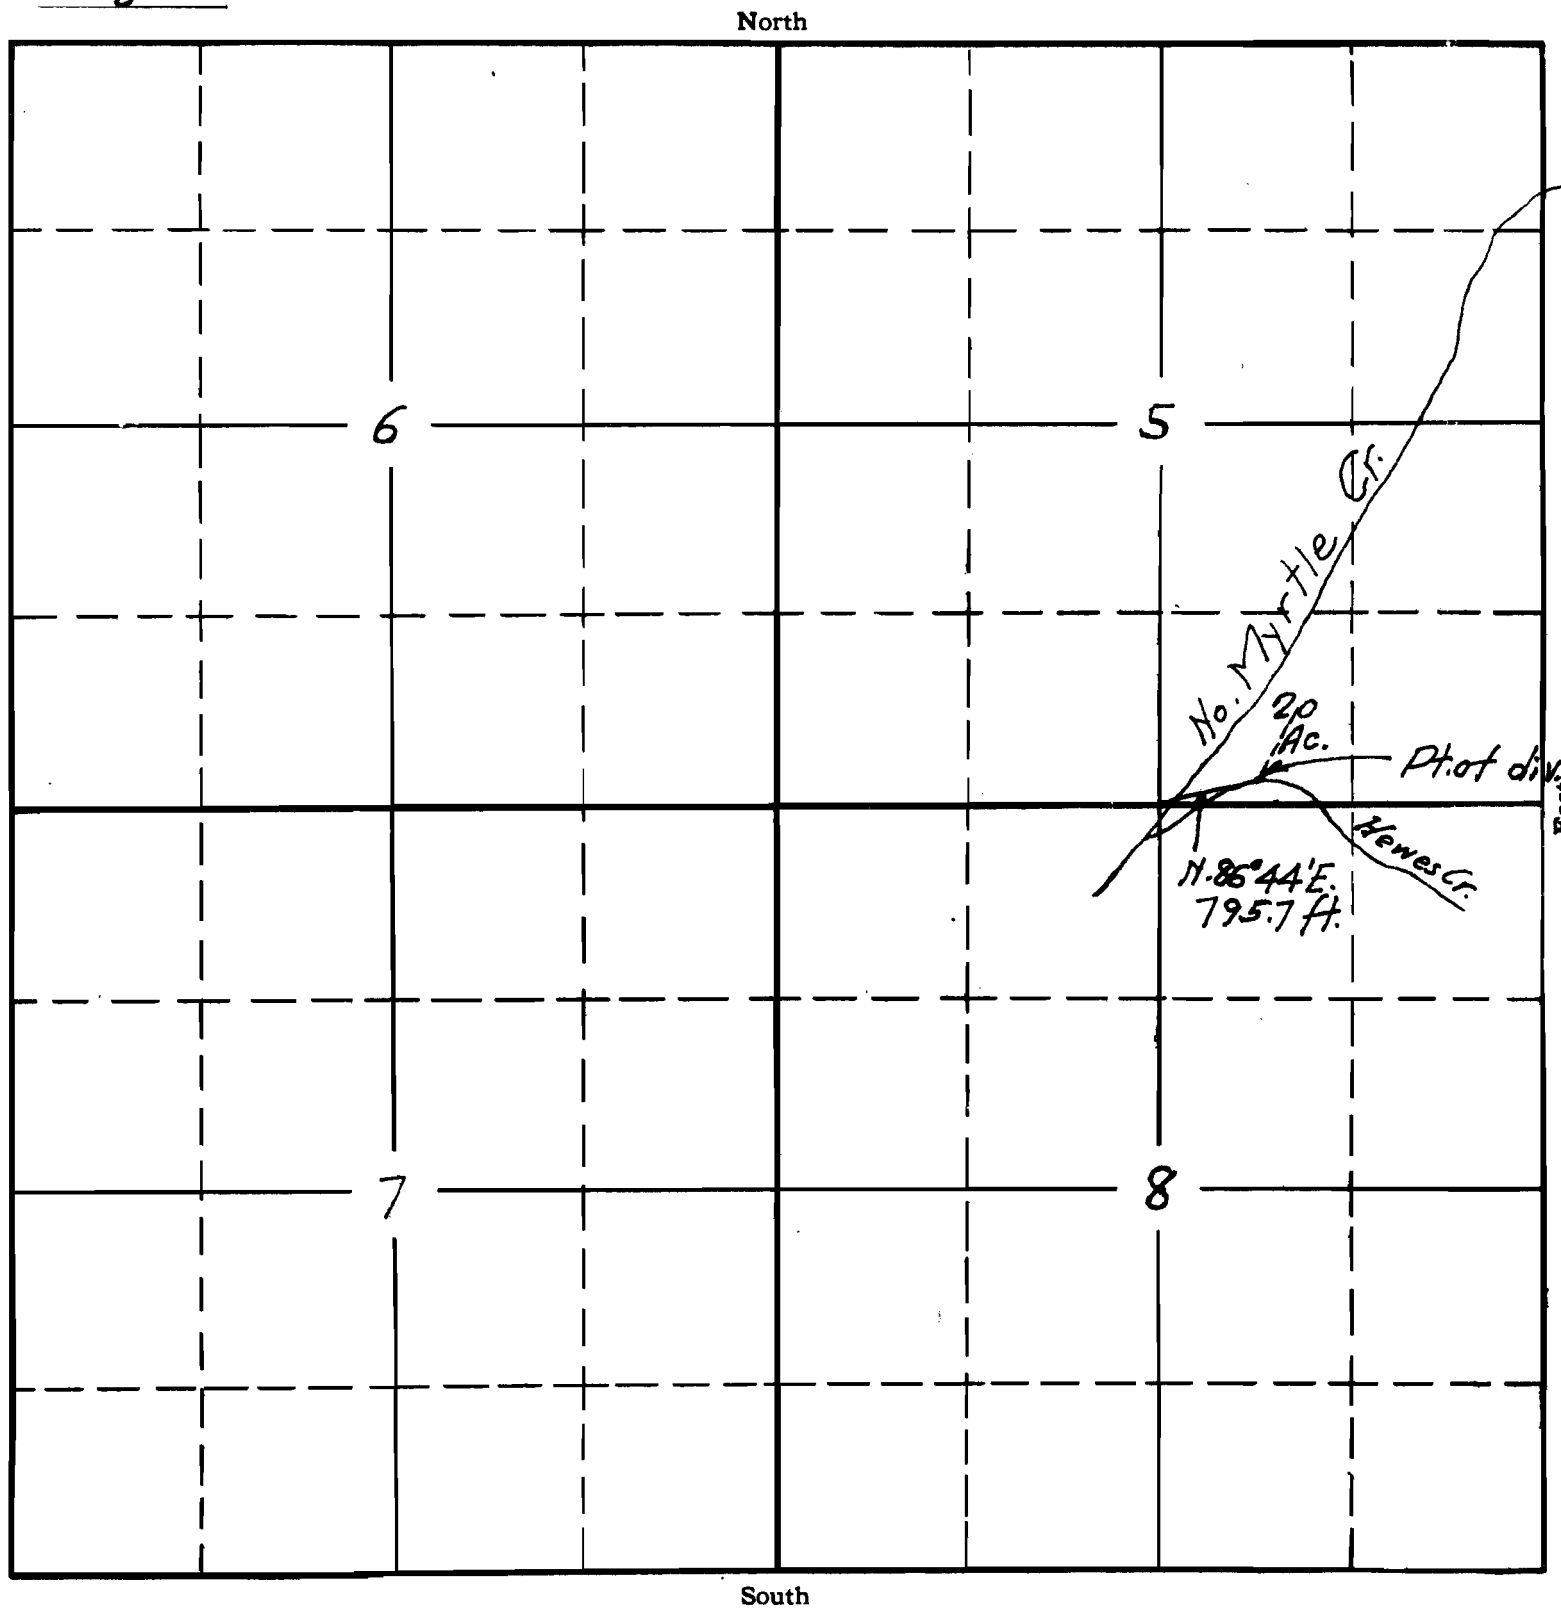

Map copied from that
for Per. 5849

APPLICATION No. 14005
PERMIT No. 10079