


SECTION

TOWNSHIP 15S, RANGE 4W, W. M.

North

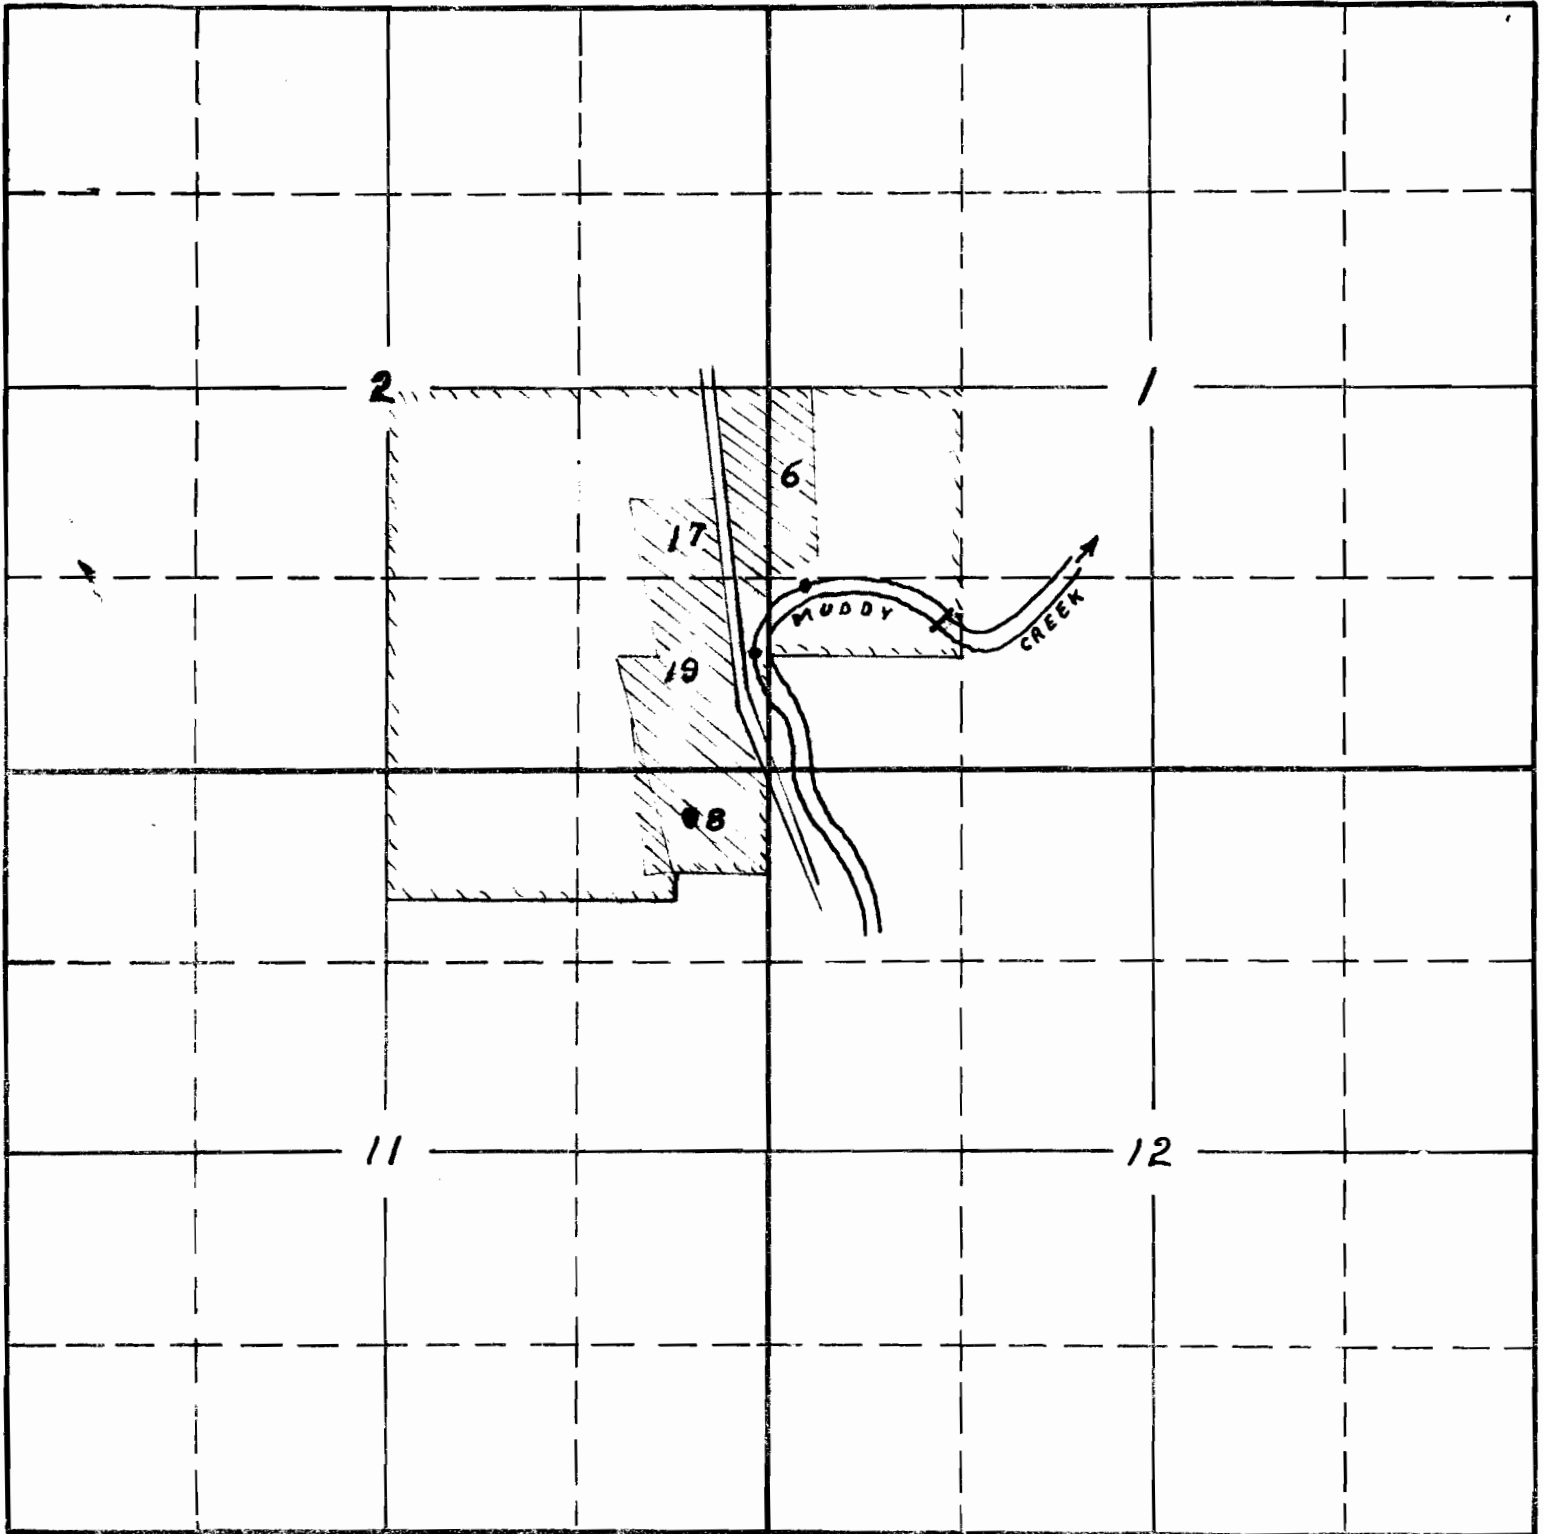

South

Amended Map filed 6/30/33 -

APPLICATION No. 14011

PERMIT No. 10082


See letter - 10/1/35 -

SECTION

- 1
- 2
- 11
- 12

TOWNSHIP 15 S, RANGE 4 W, W. M.

North

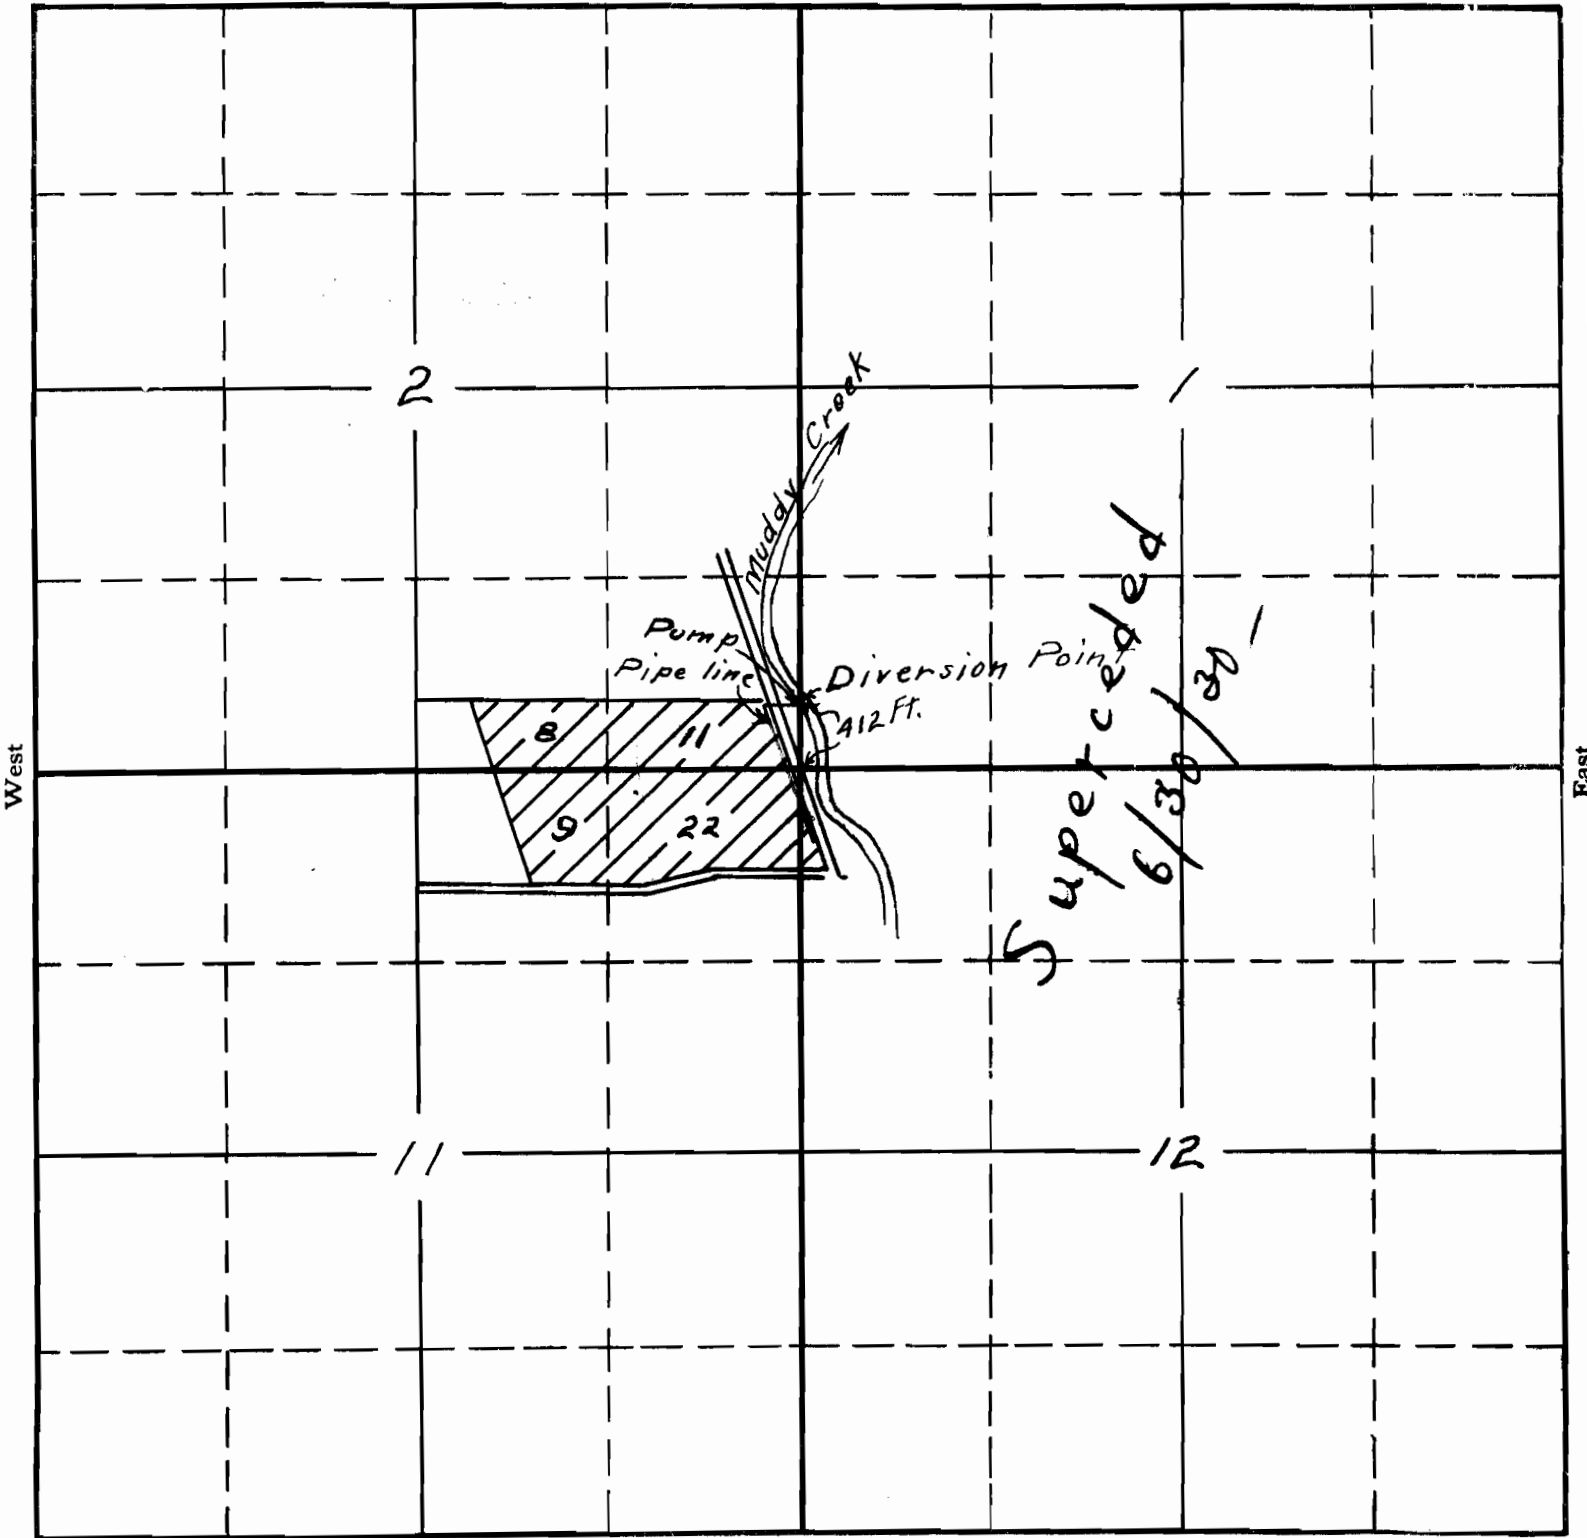

West

East

South

APPLICATION No. 14011
 PERMIT No. 10082