

T. 32 S., R. 7. W

Sketched from app. map.

App. 14034


12/10/21

SECTION

33
32
4
5

32 S
TOWNSHIP 33 S, RANGE 7 W, W. M.

North

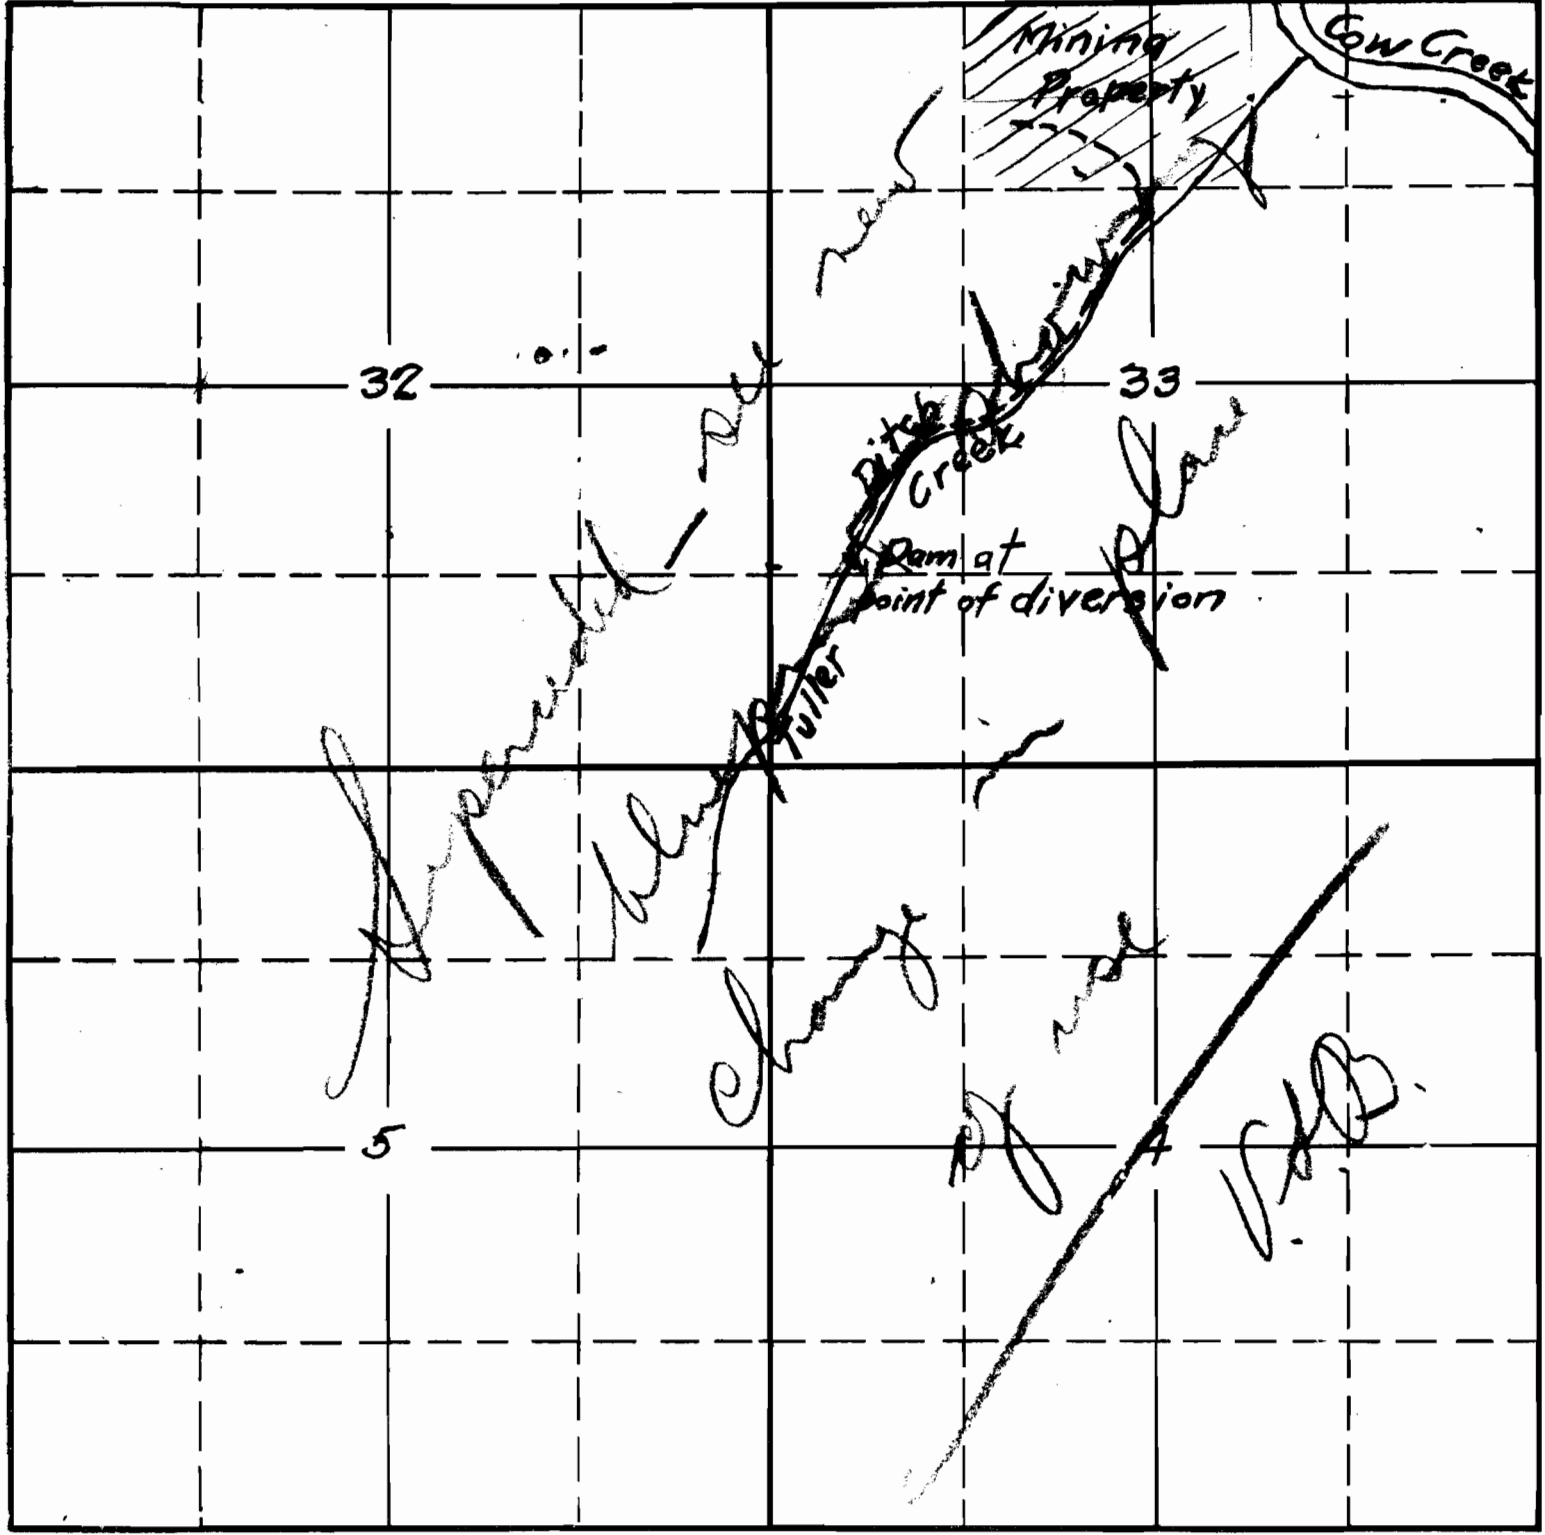

South

APPLICATION No. 14034
PERMIT No. 10121