


SECTION

4

TOWNSHIP 55, RANGE 2 W, W. M.

North

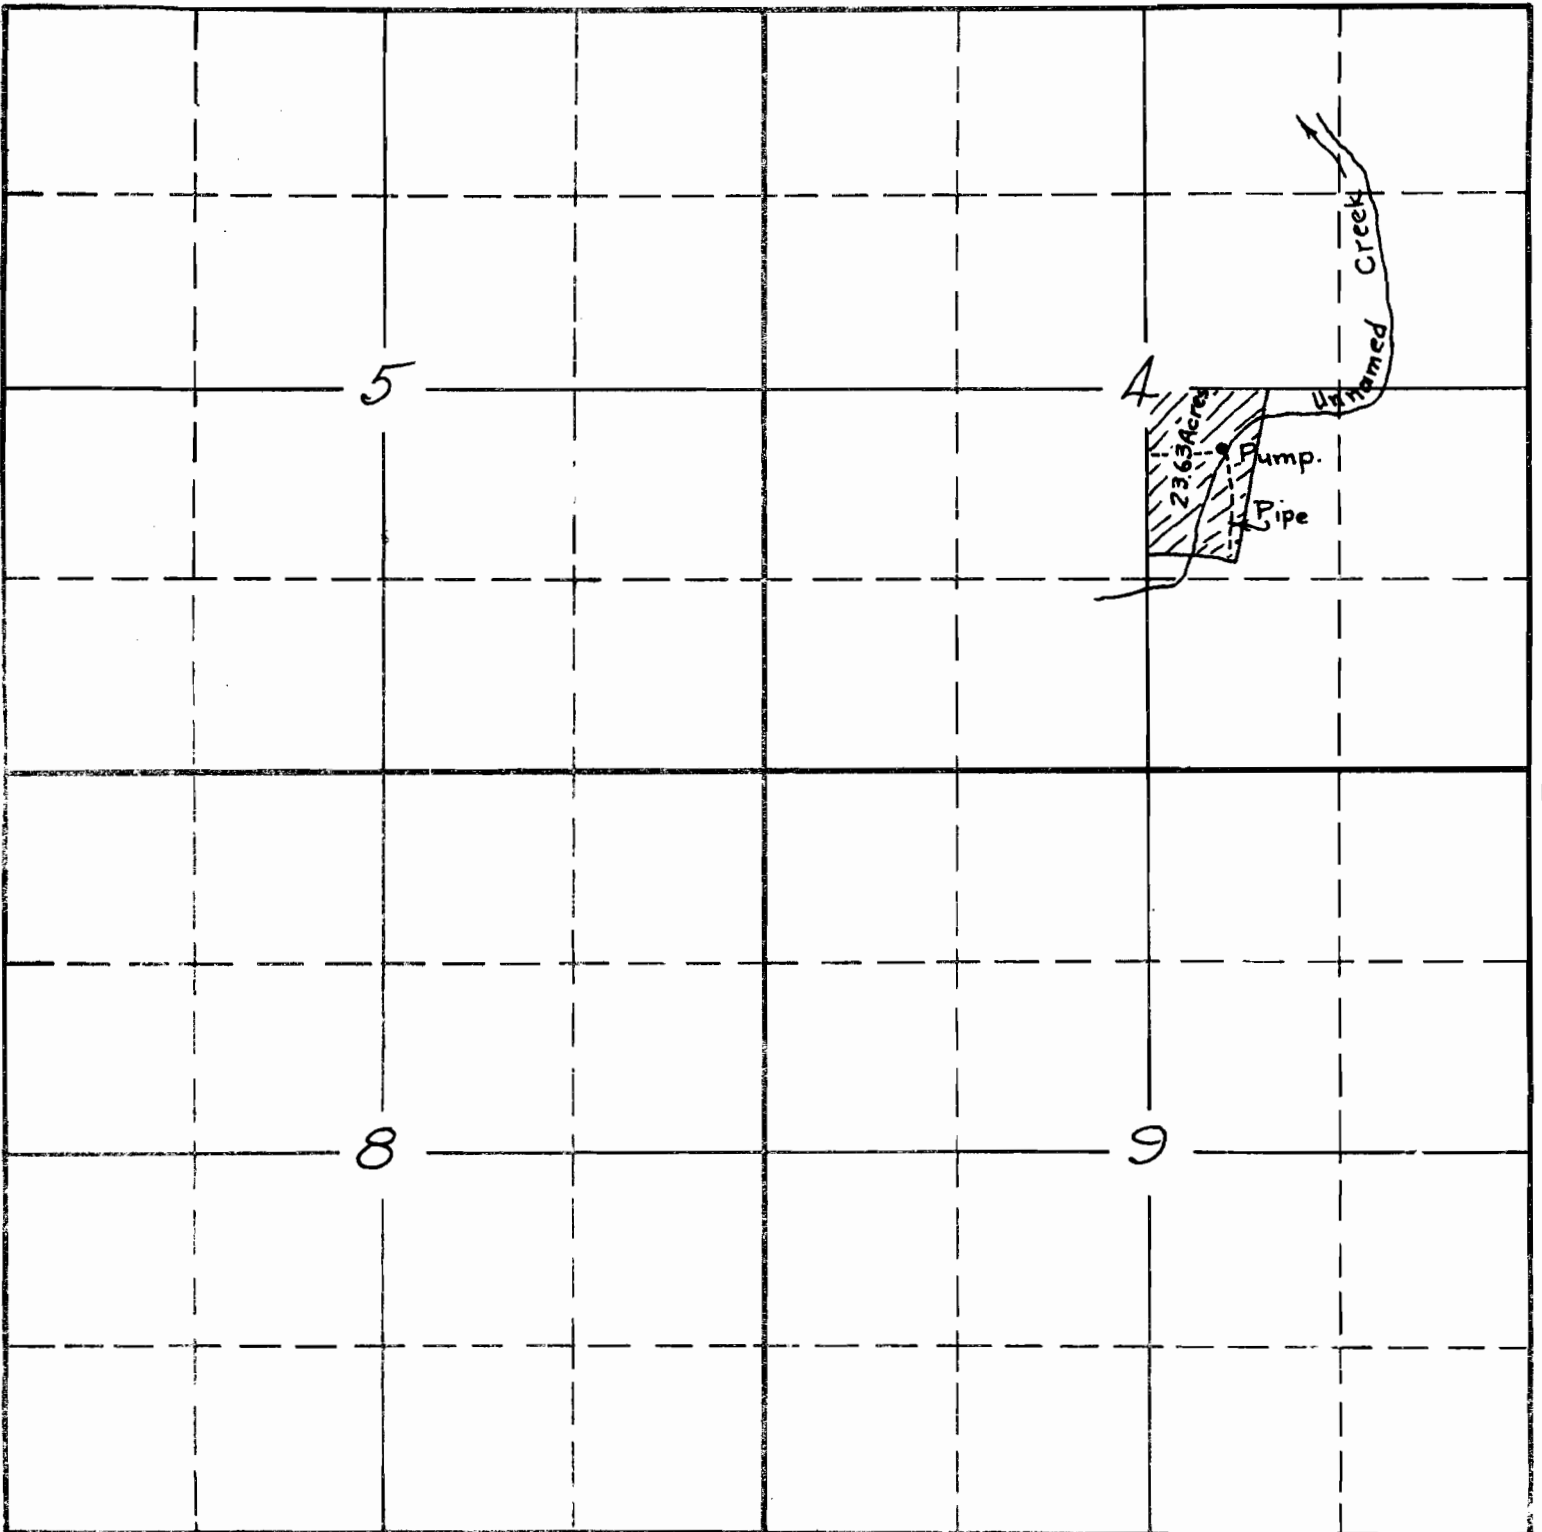

South

APPLICATION No. 14059  
PERMIT No. 10142