


SECTION

TOWNSHIP 25., RANGE 4 W., W. M.

North

West

East

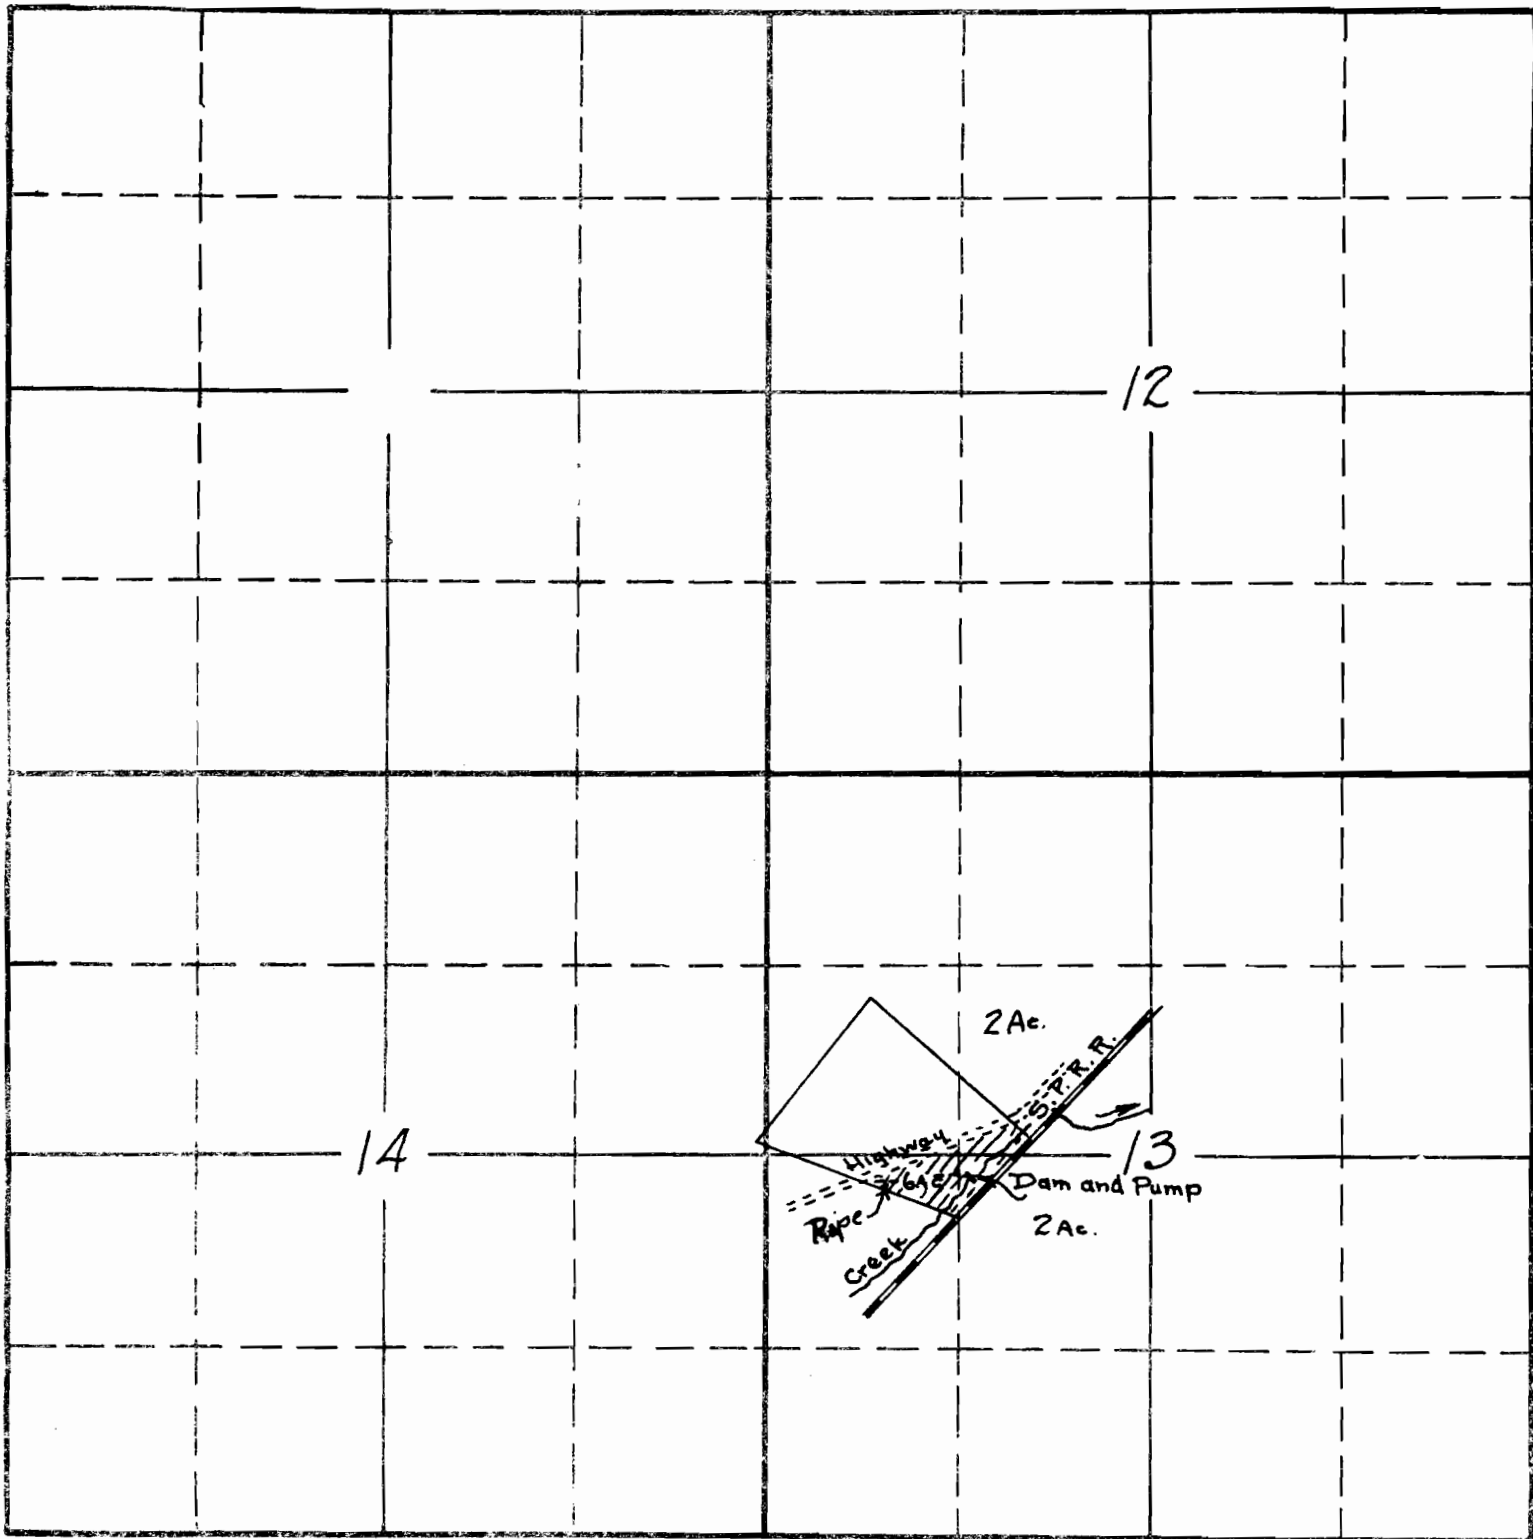

South

APPLICATION No. 14073

PERMIT No. 10148