

SECTION


TOWNSHIP 21 S, RANGE 5 W., W. M.

North

STATE IN ANGLE

33

34

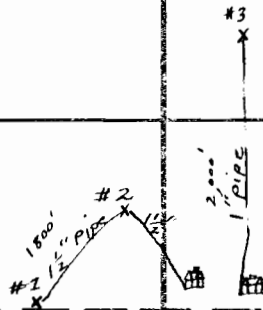

South

#1 Spring is 1295' S and 740' W. of $\frac{1}{4}$ Cor. Sec. 33 & 34
 #2 Spring is 670' S, and 290' W. of $\frac{1}{4}$ Cor. Sec. 33 & 34
 #3 Spring is 610' N. and 12' E. of $\frac{1}{4}$ Cor. Sec. 33 & 34

APPLICATION No. 14171
 PERMIT No. 10246