


SECTION

TOWNSHIP 185, RANGE 5W, W. M.

North

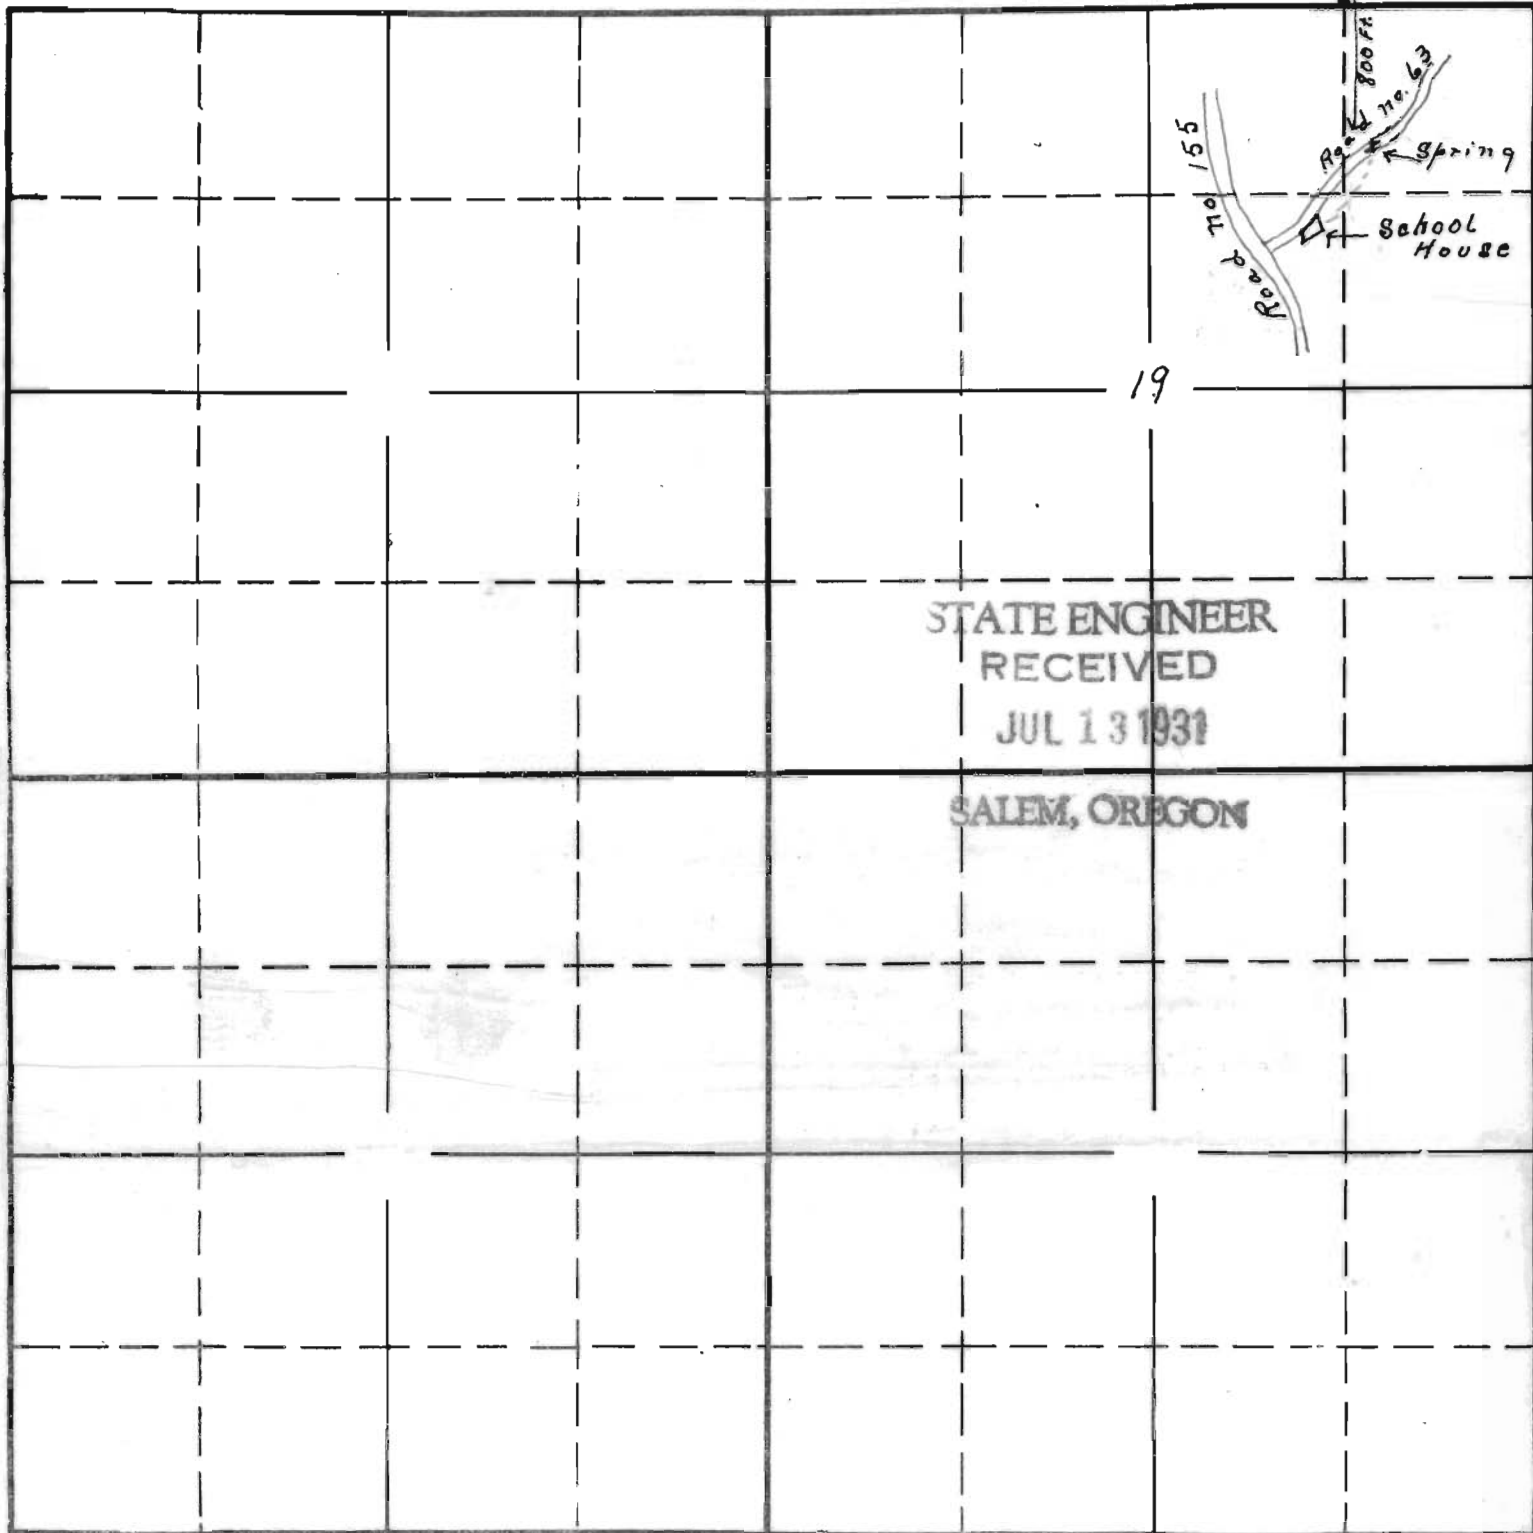

19

STATE ENGINEER
RECEIVED
JUL 13 1931

SALEM, OREGON

South

APPLICATION No. 14197
PERMIT No. 10256