


SECTION

27

TOWNSHIP II S. RANGE 5 W. W. M.

North

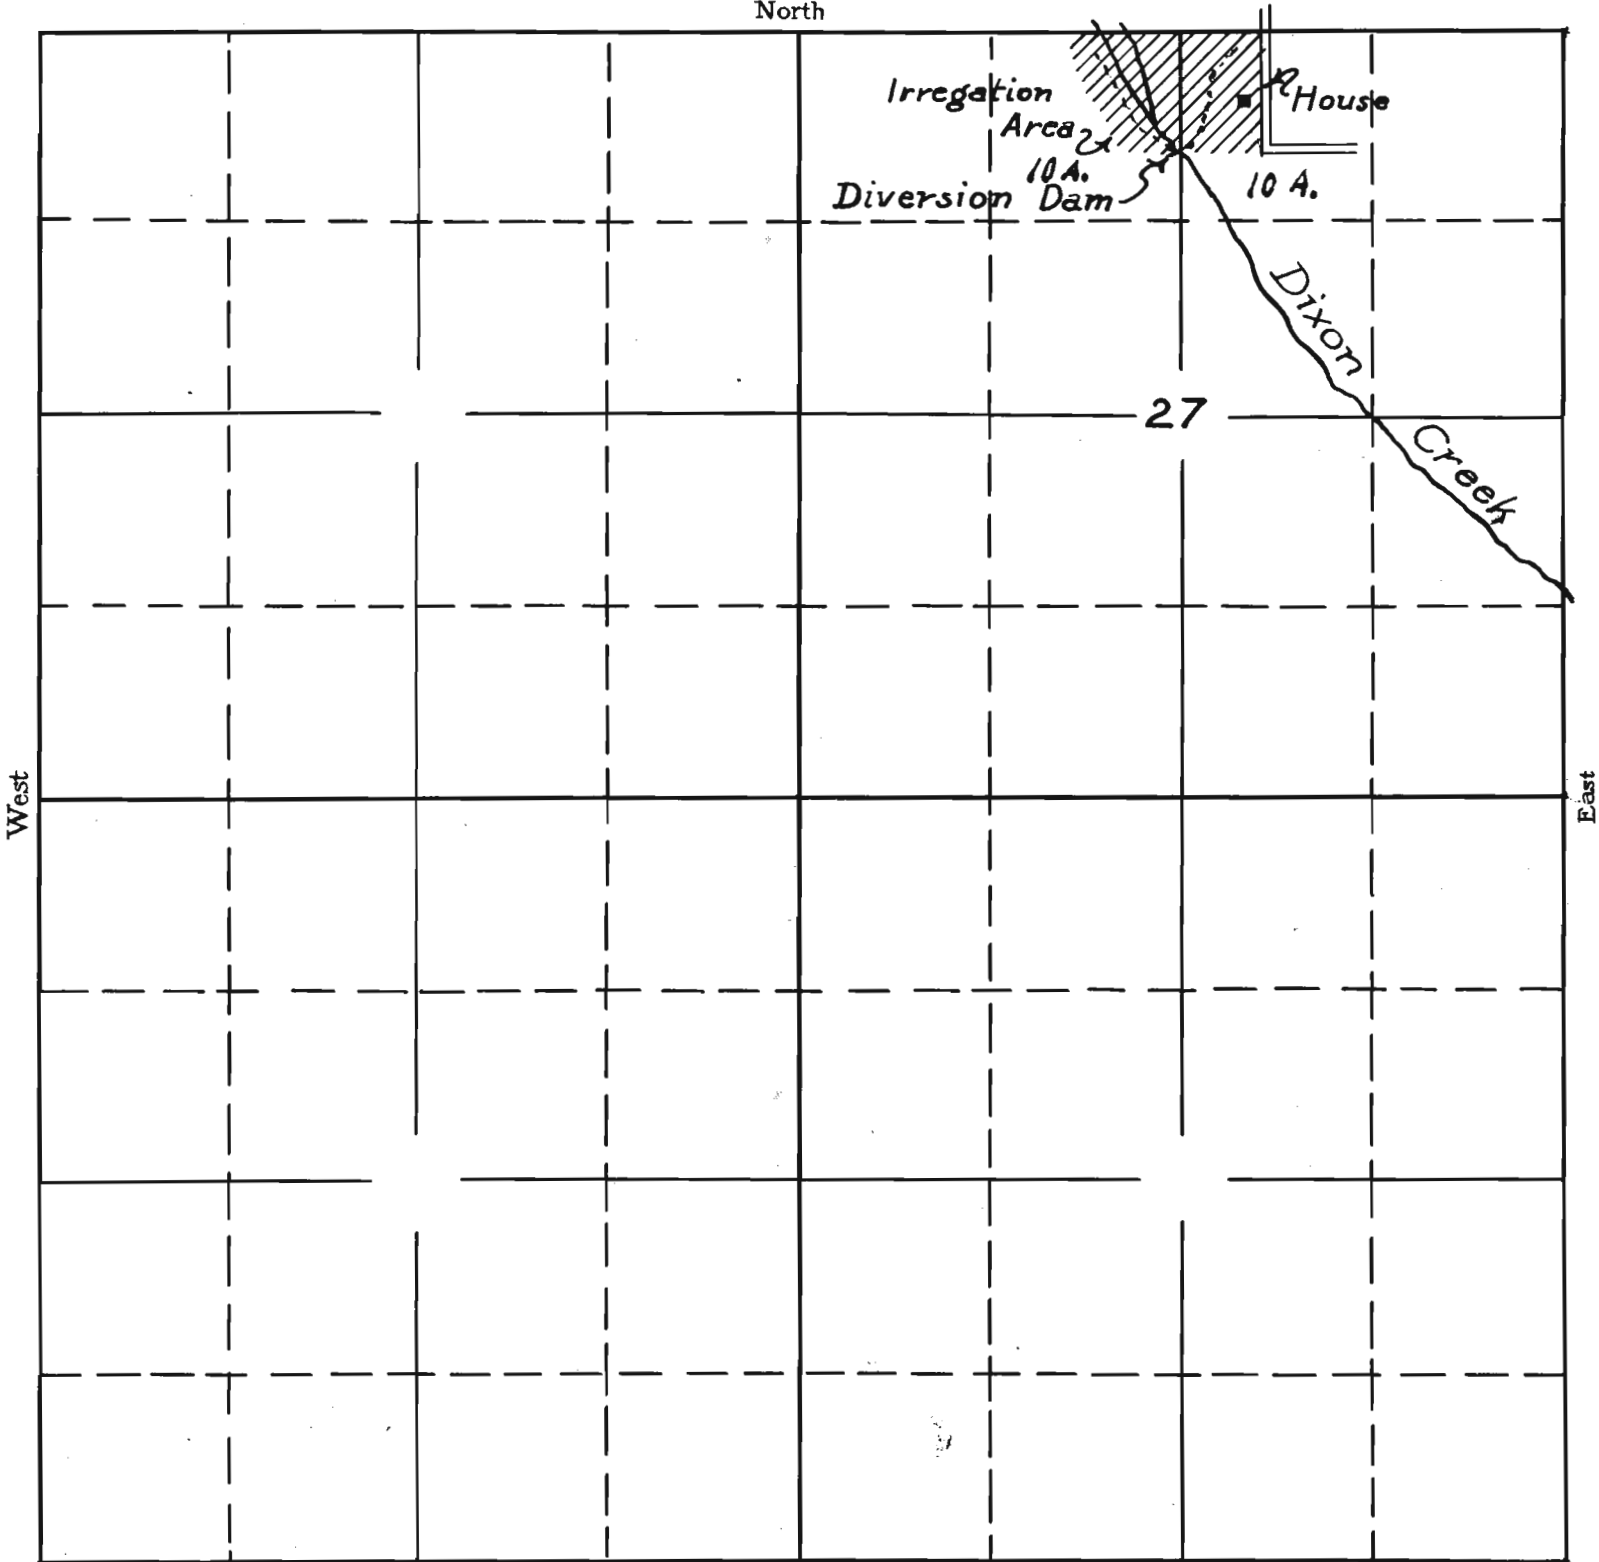

27

West

East

South

1"=1320'

APPLICATION No 14200

PERMIT No. 10263