


T. 39S., R. 8 W. W.M.

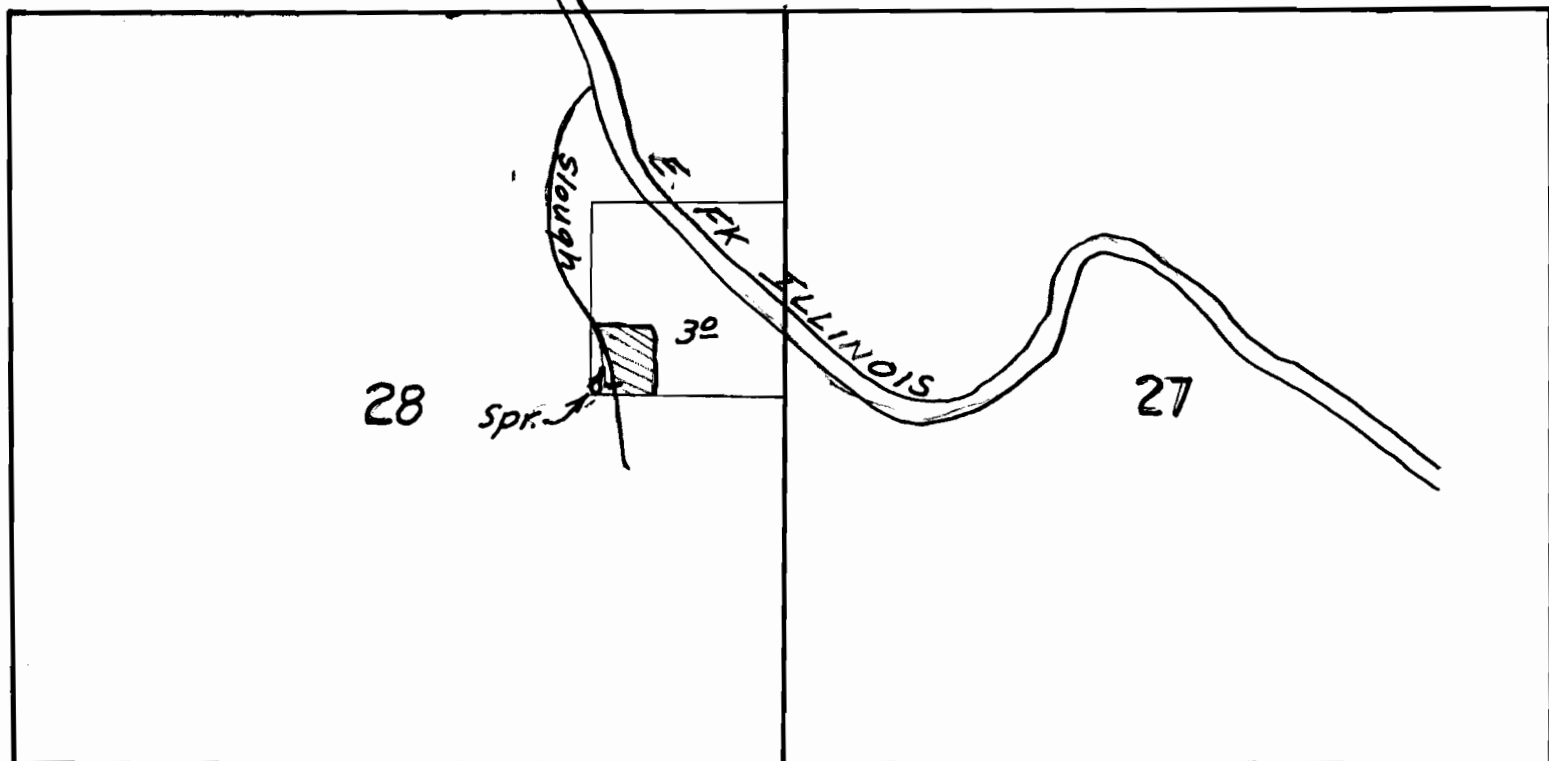

Sketched from proof map

App 14214


SECTION

27

28

TOWNSHIP 39 S, RANGE 8 W, W. M.

North

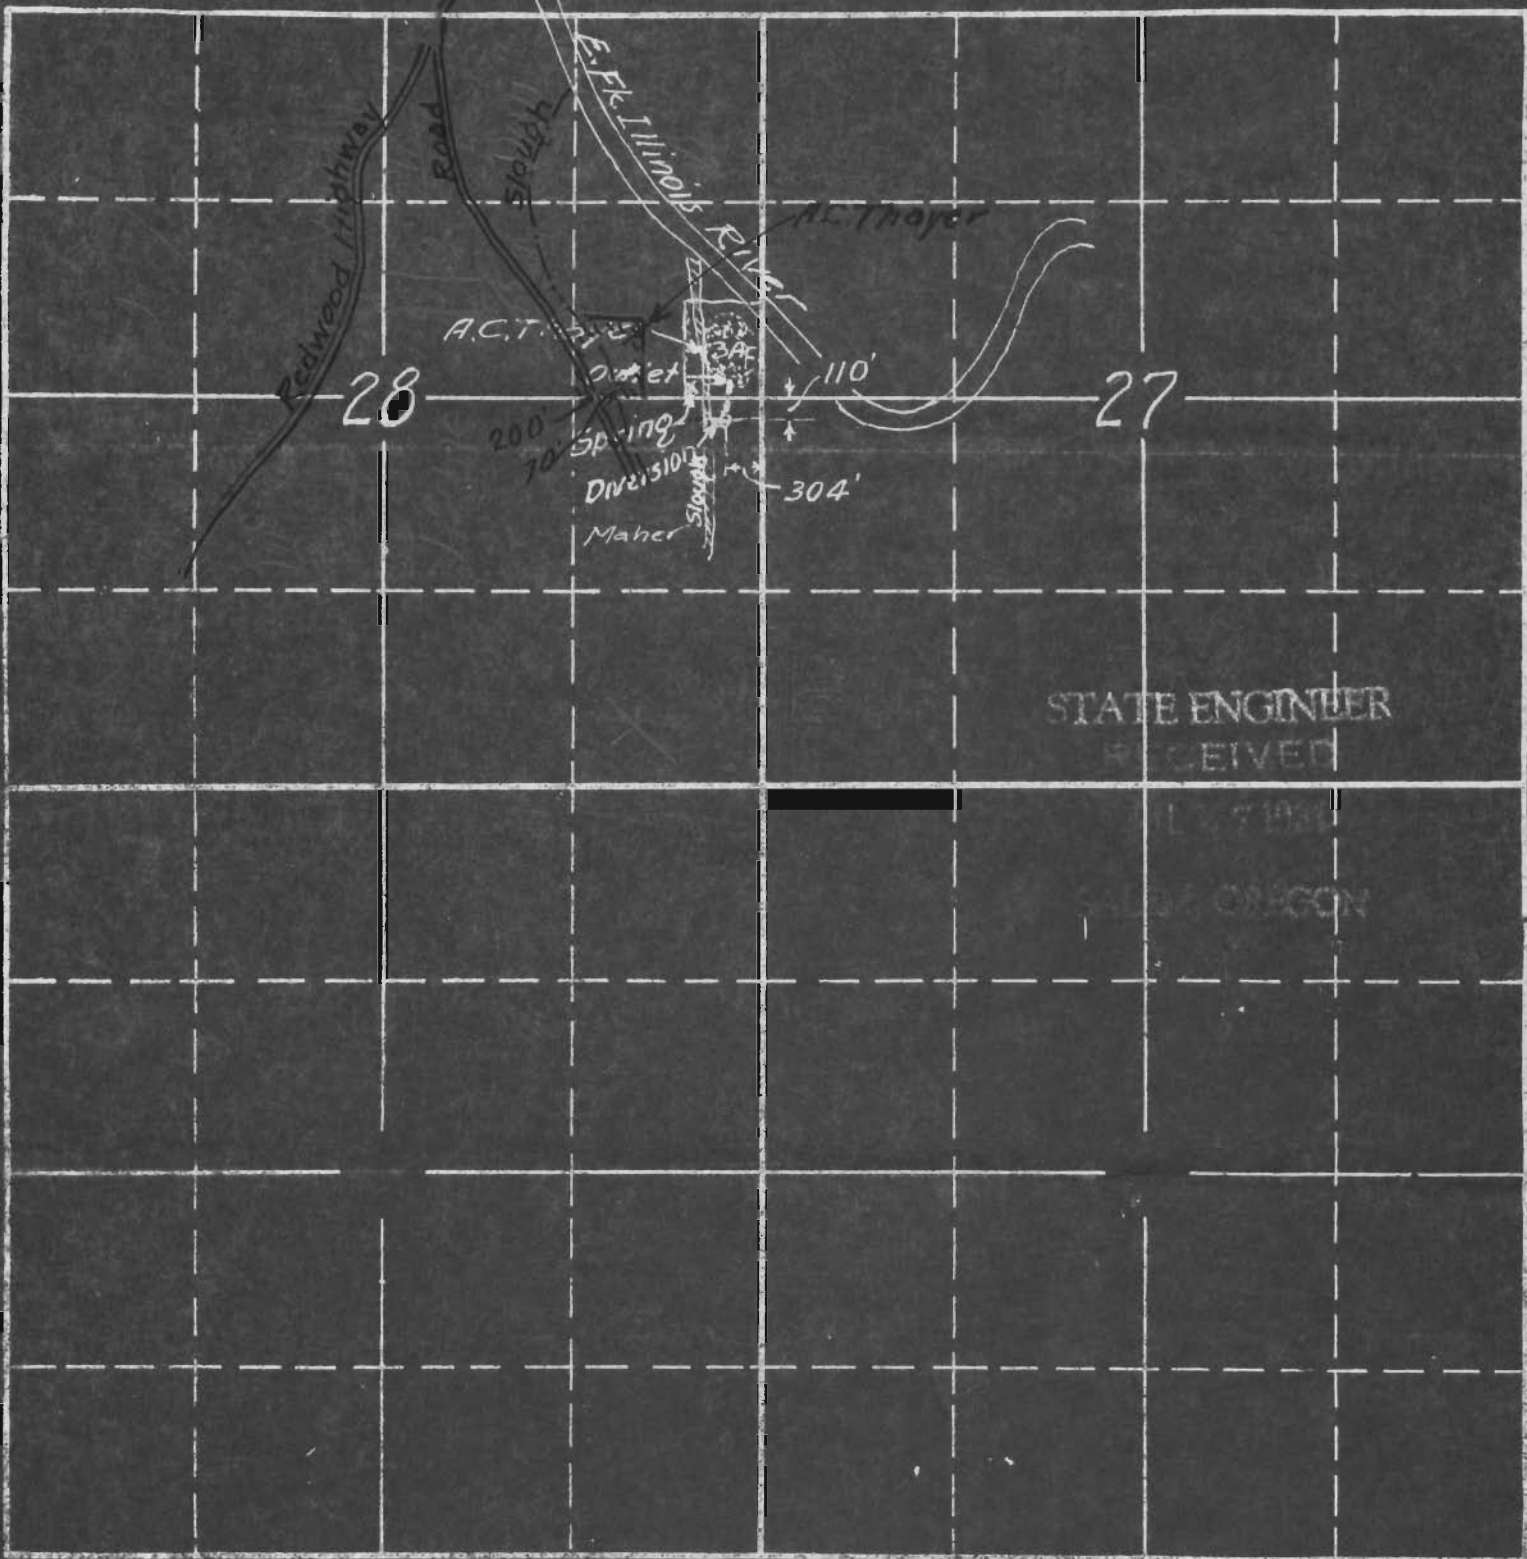

South

APPLICATION No. 14214

PERMIT No. 10271