

SECTION

21
22
27
28

TOWNSHIP 39 S, RANGE 8 N


Permit: S 10274
Volume: 8
Strm: UNN SWAMP
Trib: E FK ILLINOIS R
Priority: 7/29/31
10614

North

STATE ENGINEER
RECEIVED

JUL 29 1931

SALIM, OREGON

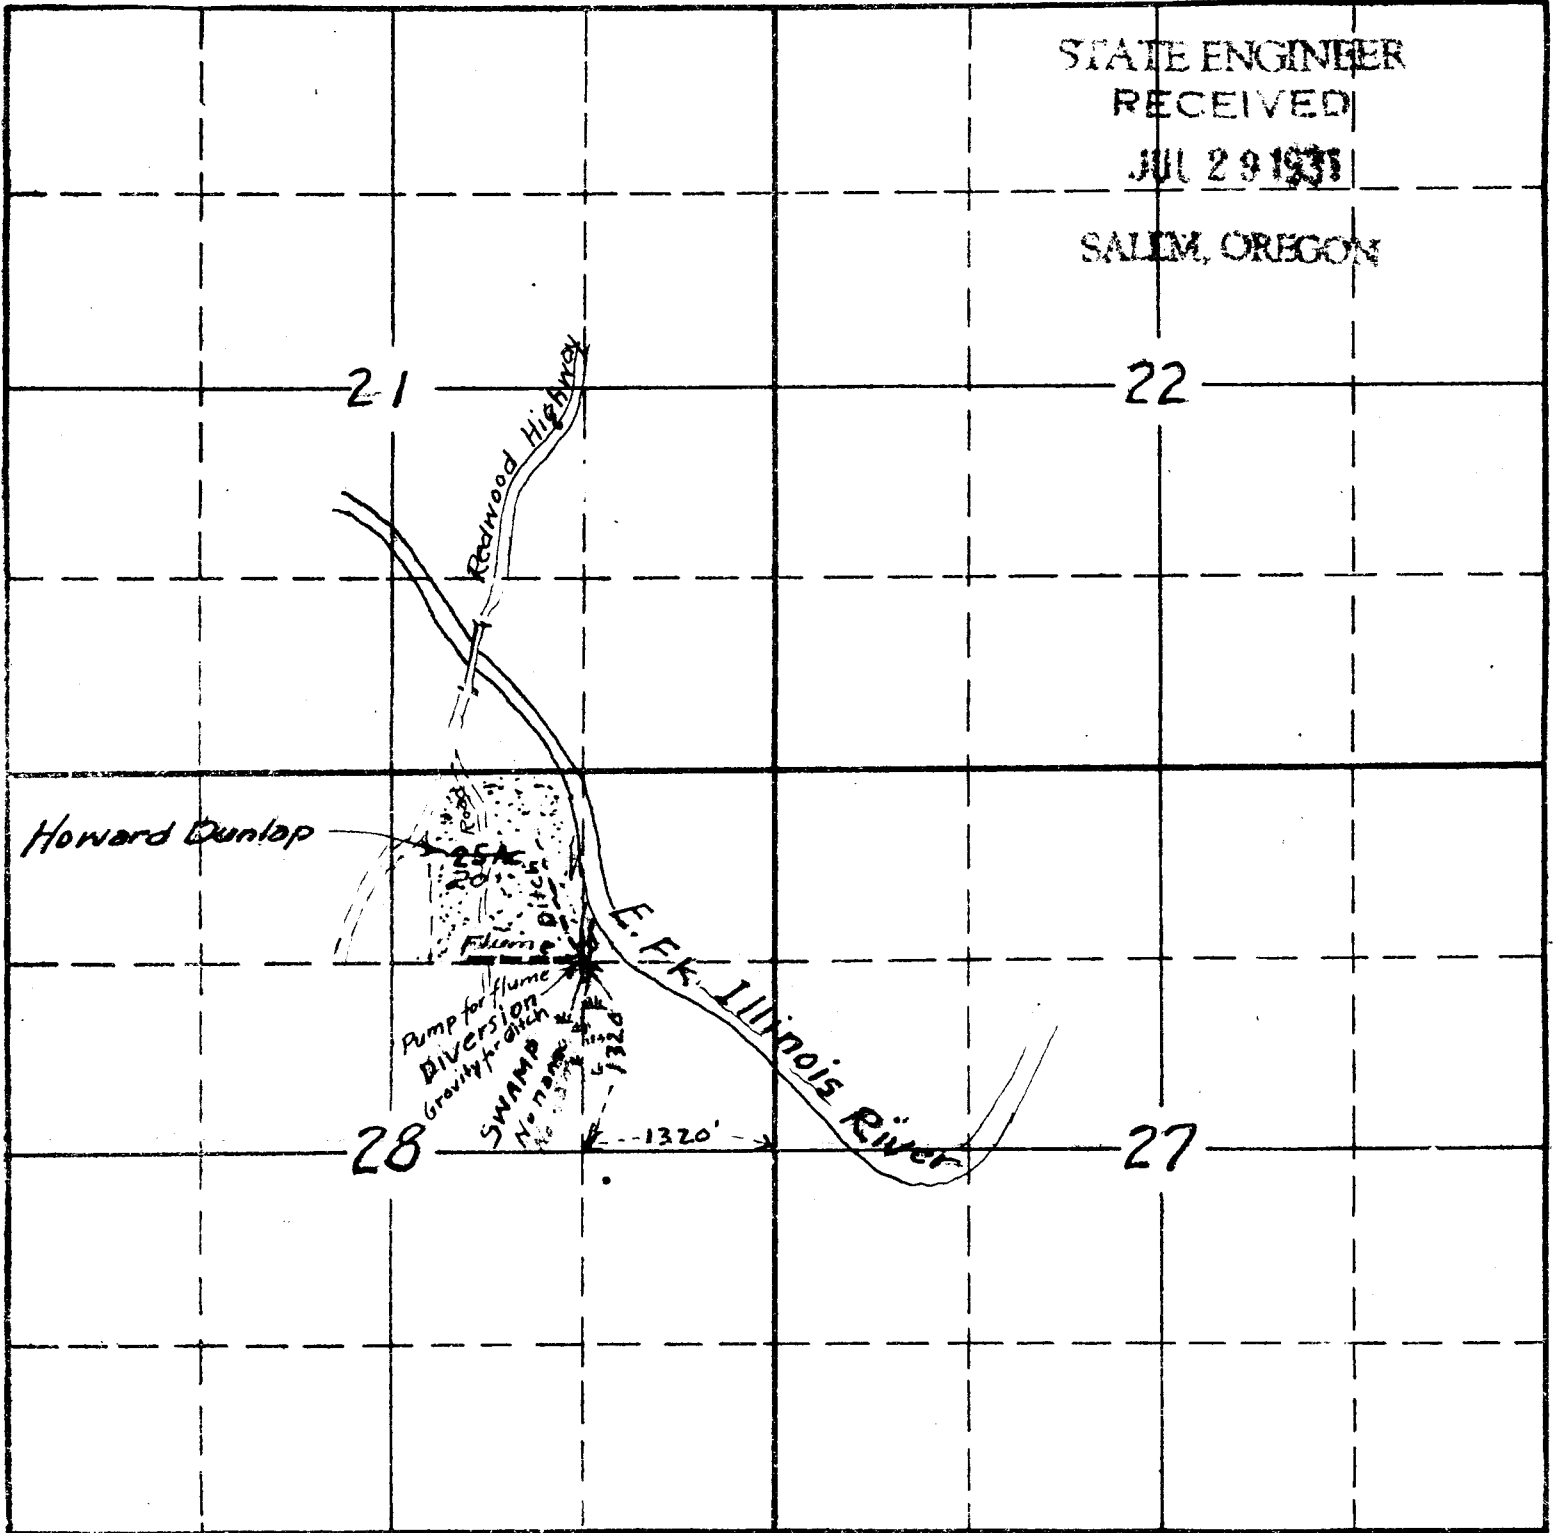

South

APPLICATION No. 14217
PERMIT No. 10274