


TOWNSHIP 5 N, RANGE 7 W, W. M.

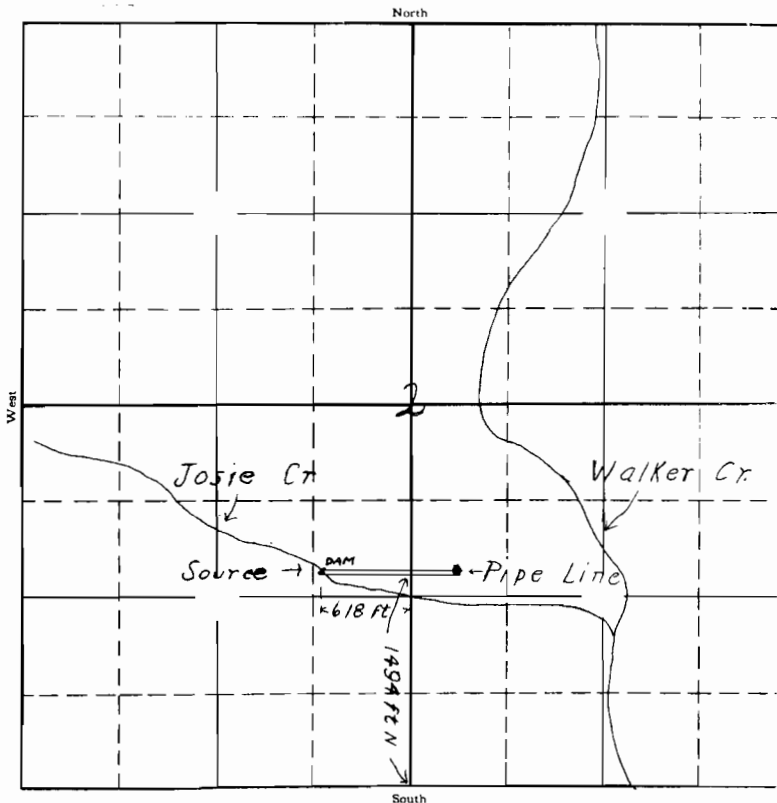

Water System F H Wooden

Jewell Oreg

APPLICATION No. 14219
PERMIT No. 10275