

SECTION


\_\_\_\_\_

\_\_\_\_\_

\_\_\_\_\_


\_\_\_\_\_

TOWNSHIP 25, RANGE 1 E, W. M.

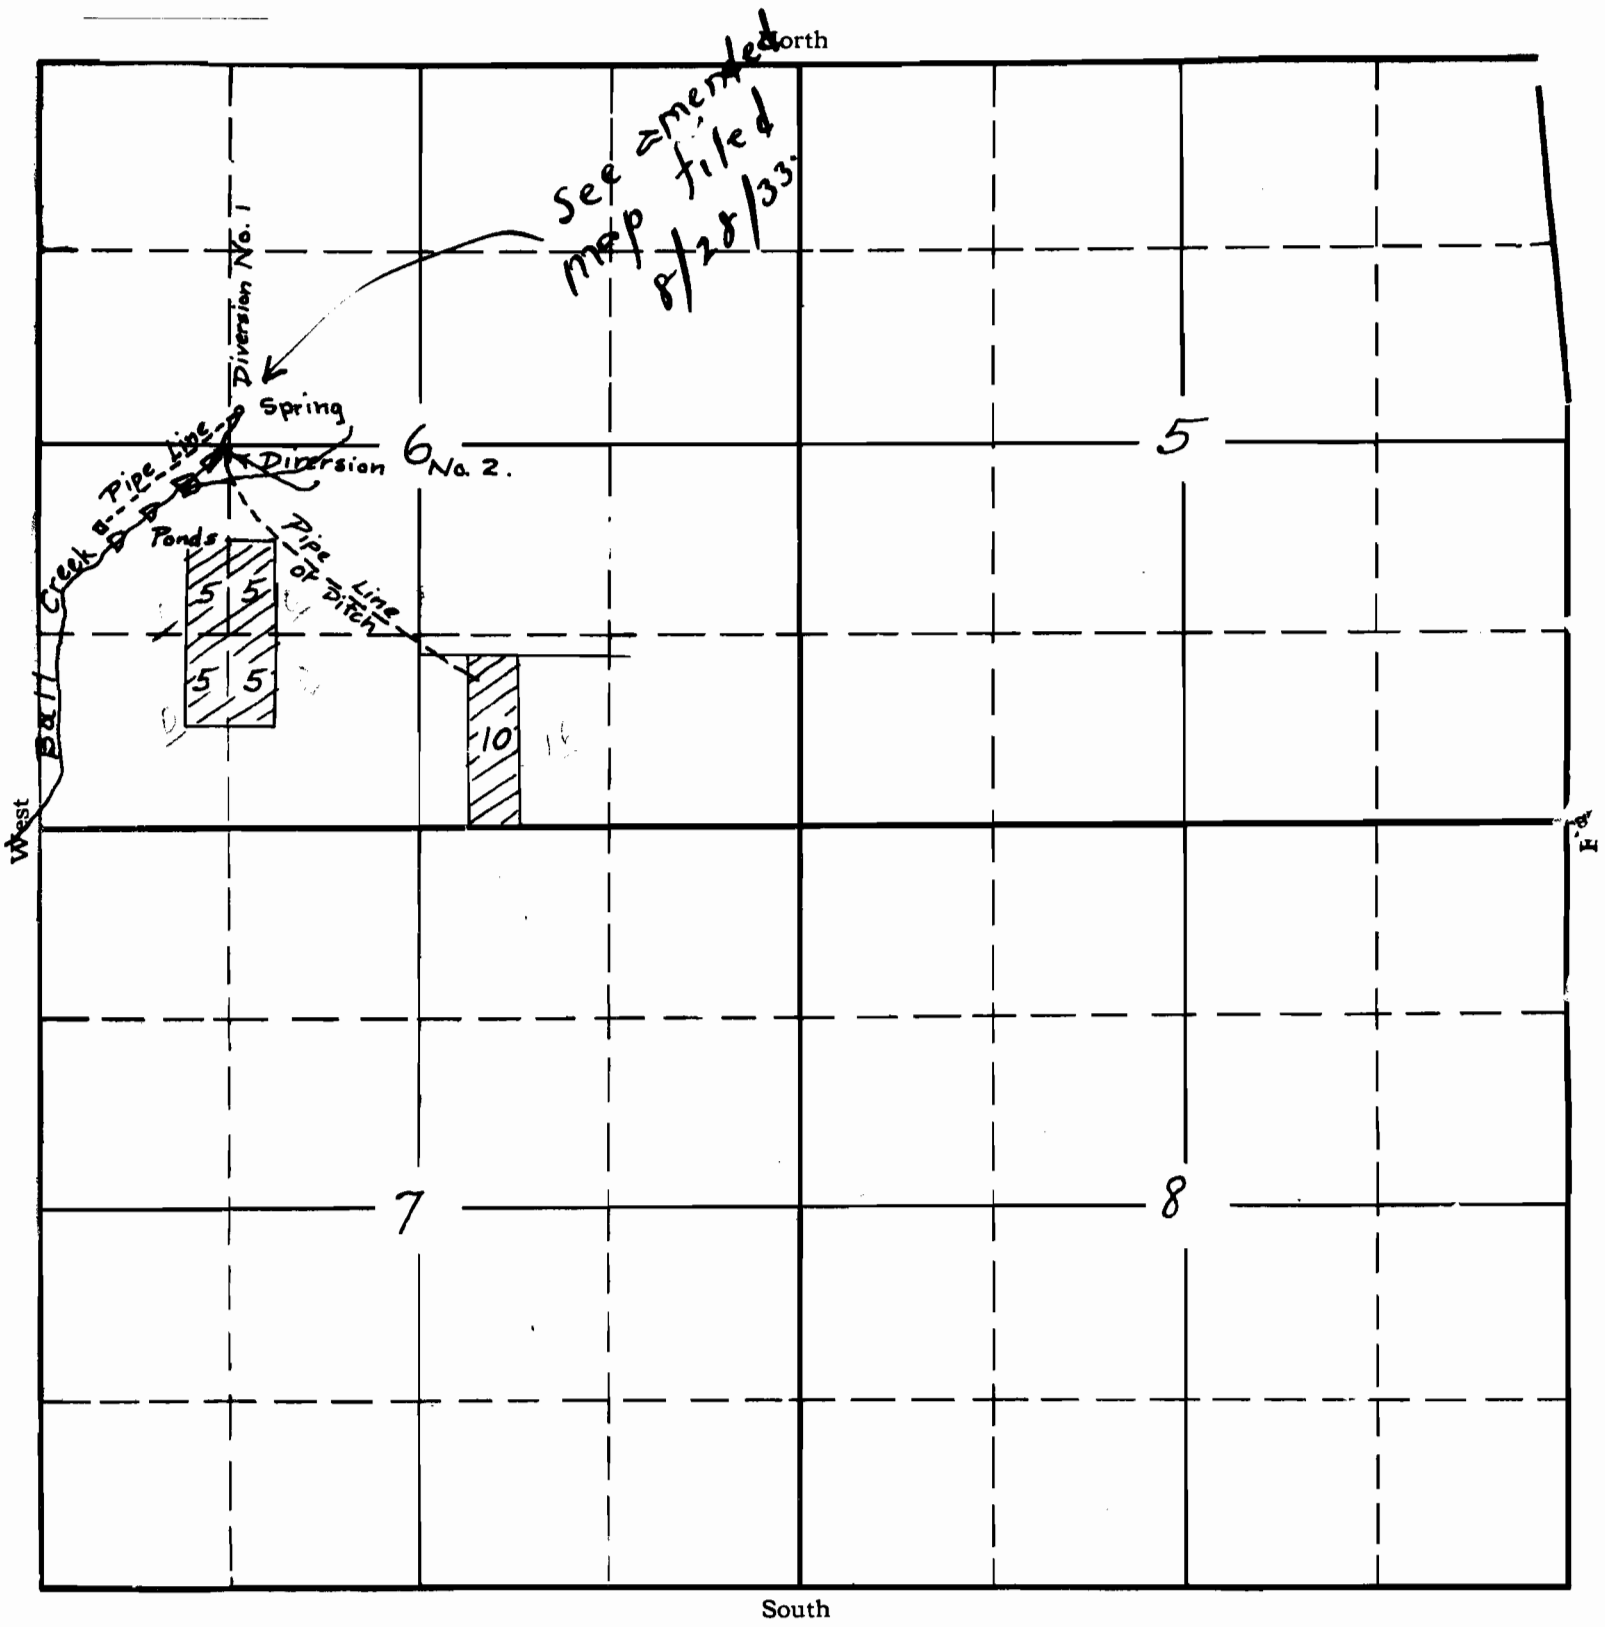

APPLICATION No. 14268  

SPRING LOCATION  
N.W. 1/4 SEC. 6 T.25.R.1.E.  
W.M. CLACKAMAS Co.  
OREGON.

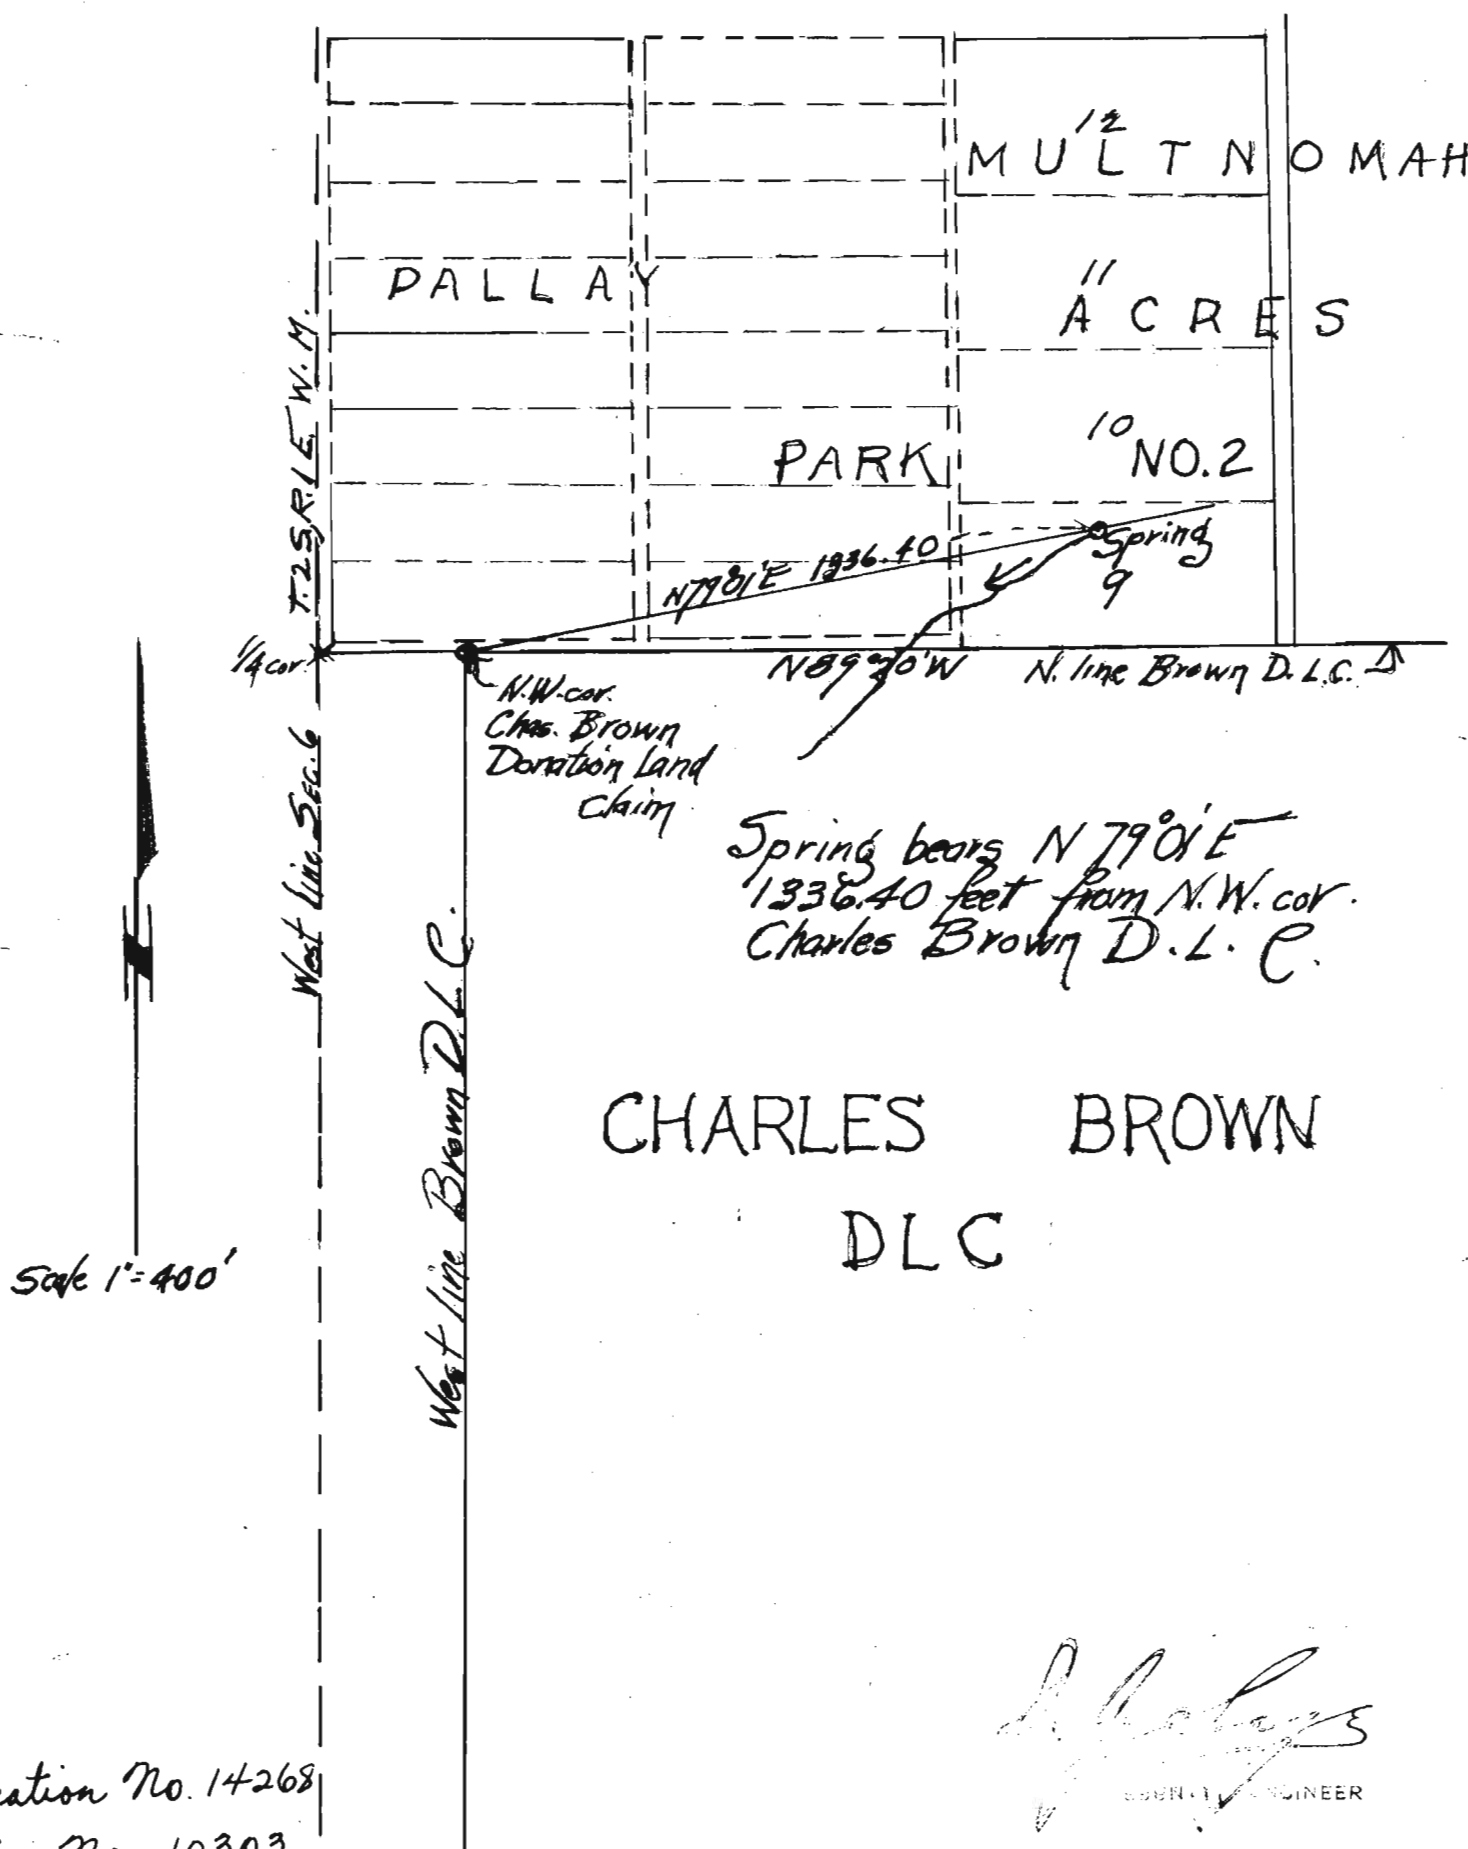

Application No. 14268  
Permit No. 10303

Amended map filed 8/28/33.  
showing correct location of spring.