


TOWNSHIP 39S , RANGE 2E , W. M.

North

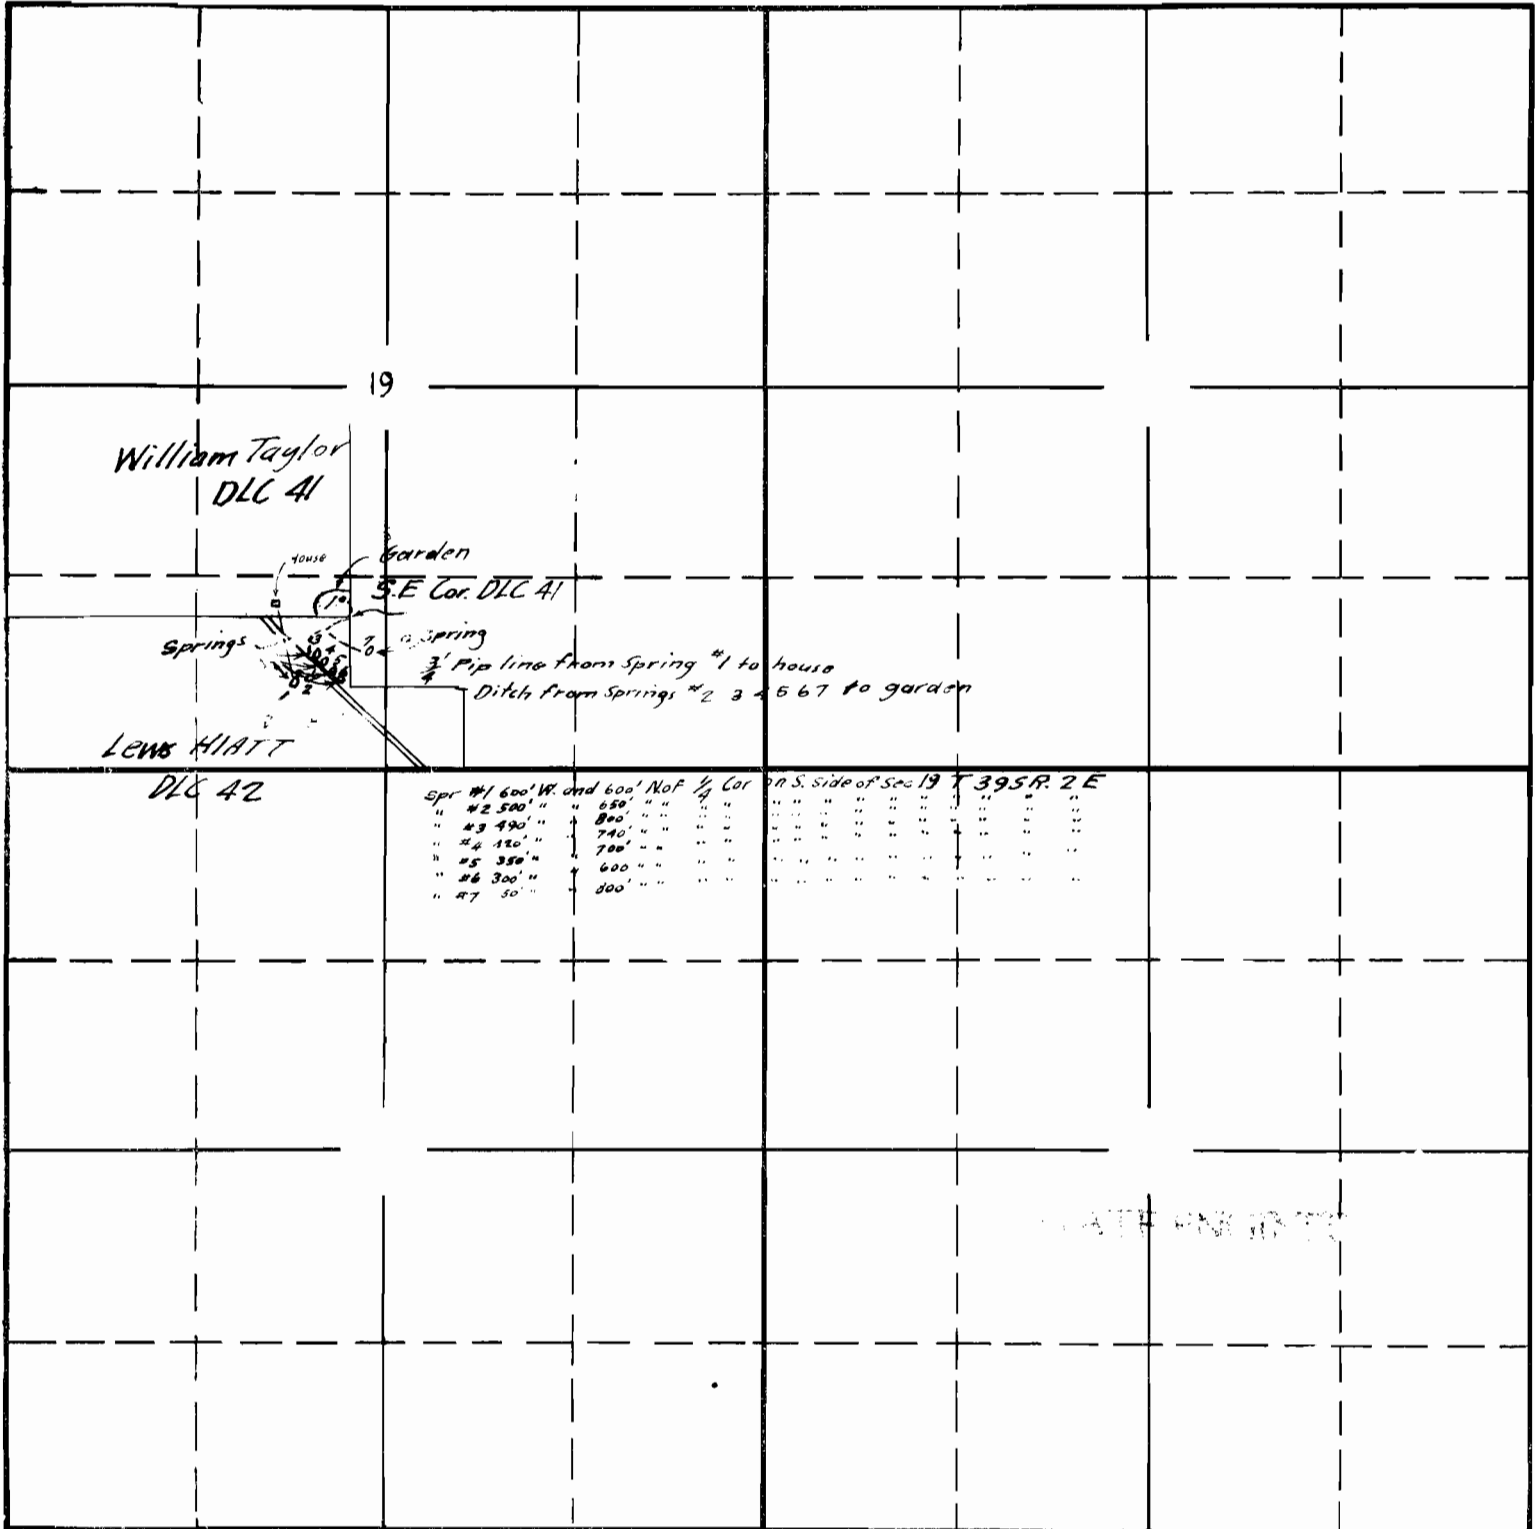

19

William Taylor
DLC 41

Garden

S.E. Cor. DLC 41

Springs

Spring

3/4" Pipe line from Spring #1 to house

Ditch from Springs #2 3 4 5 6 7 to garden

Lewis HIATT
DLC 42

Spr #1	600' W. and 600' N of 1/4 Cor	on S. side of Sec 19 T 39S R. 2 E

South