


N.

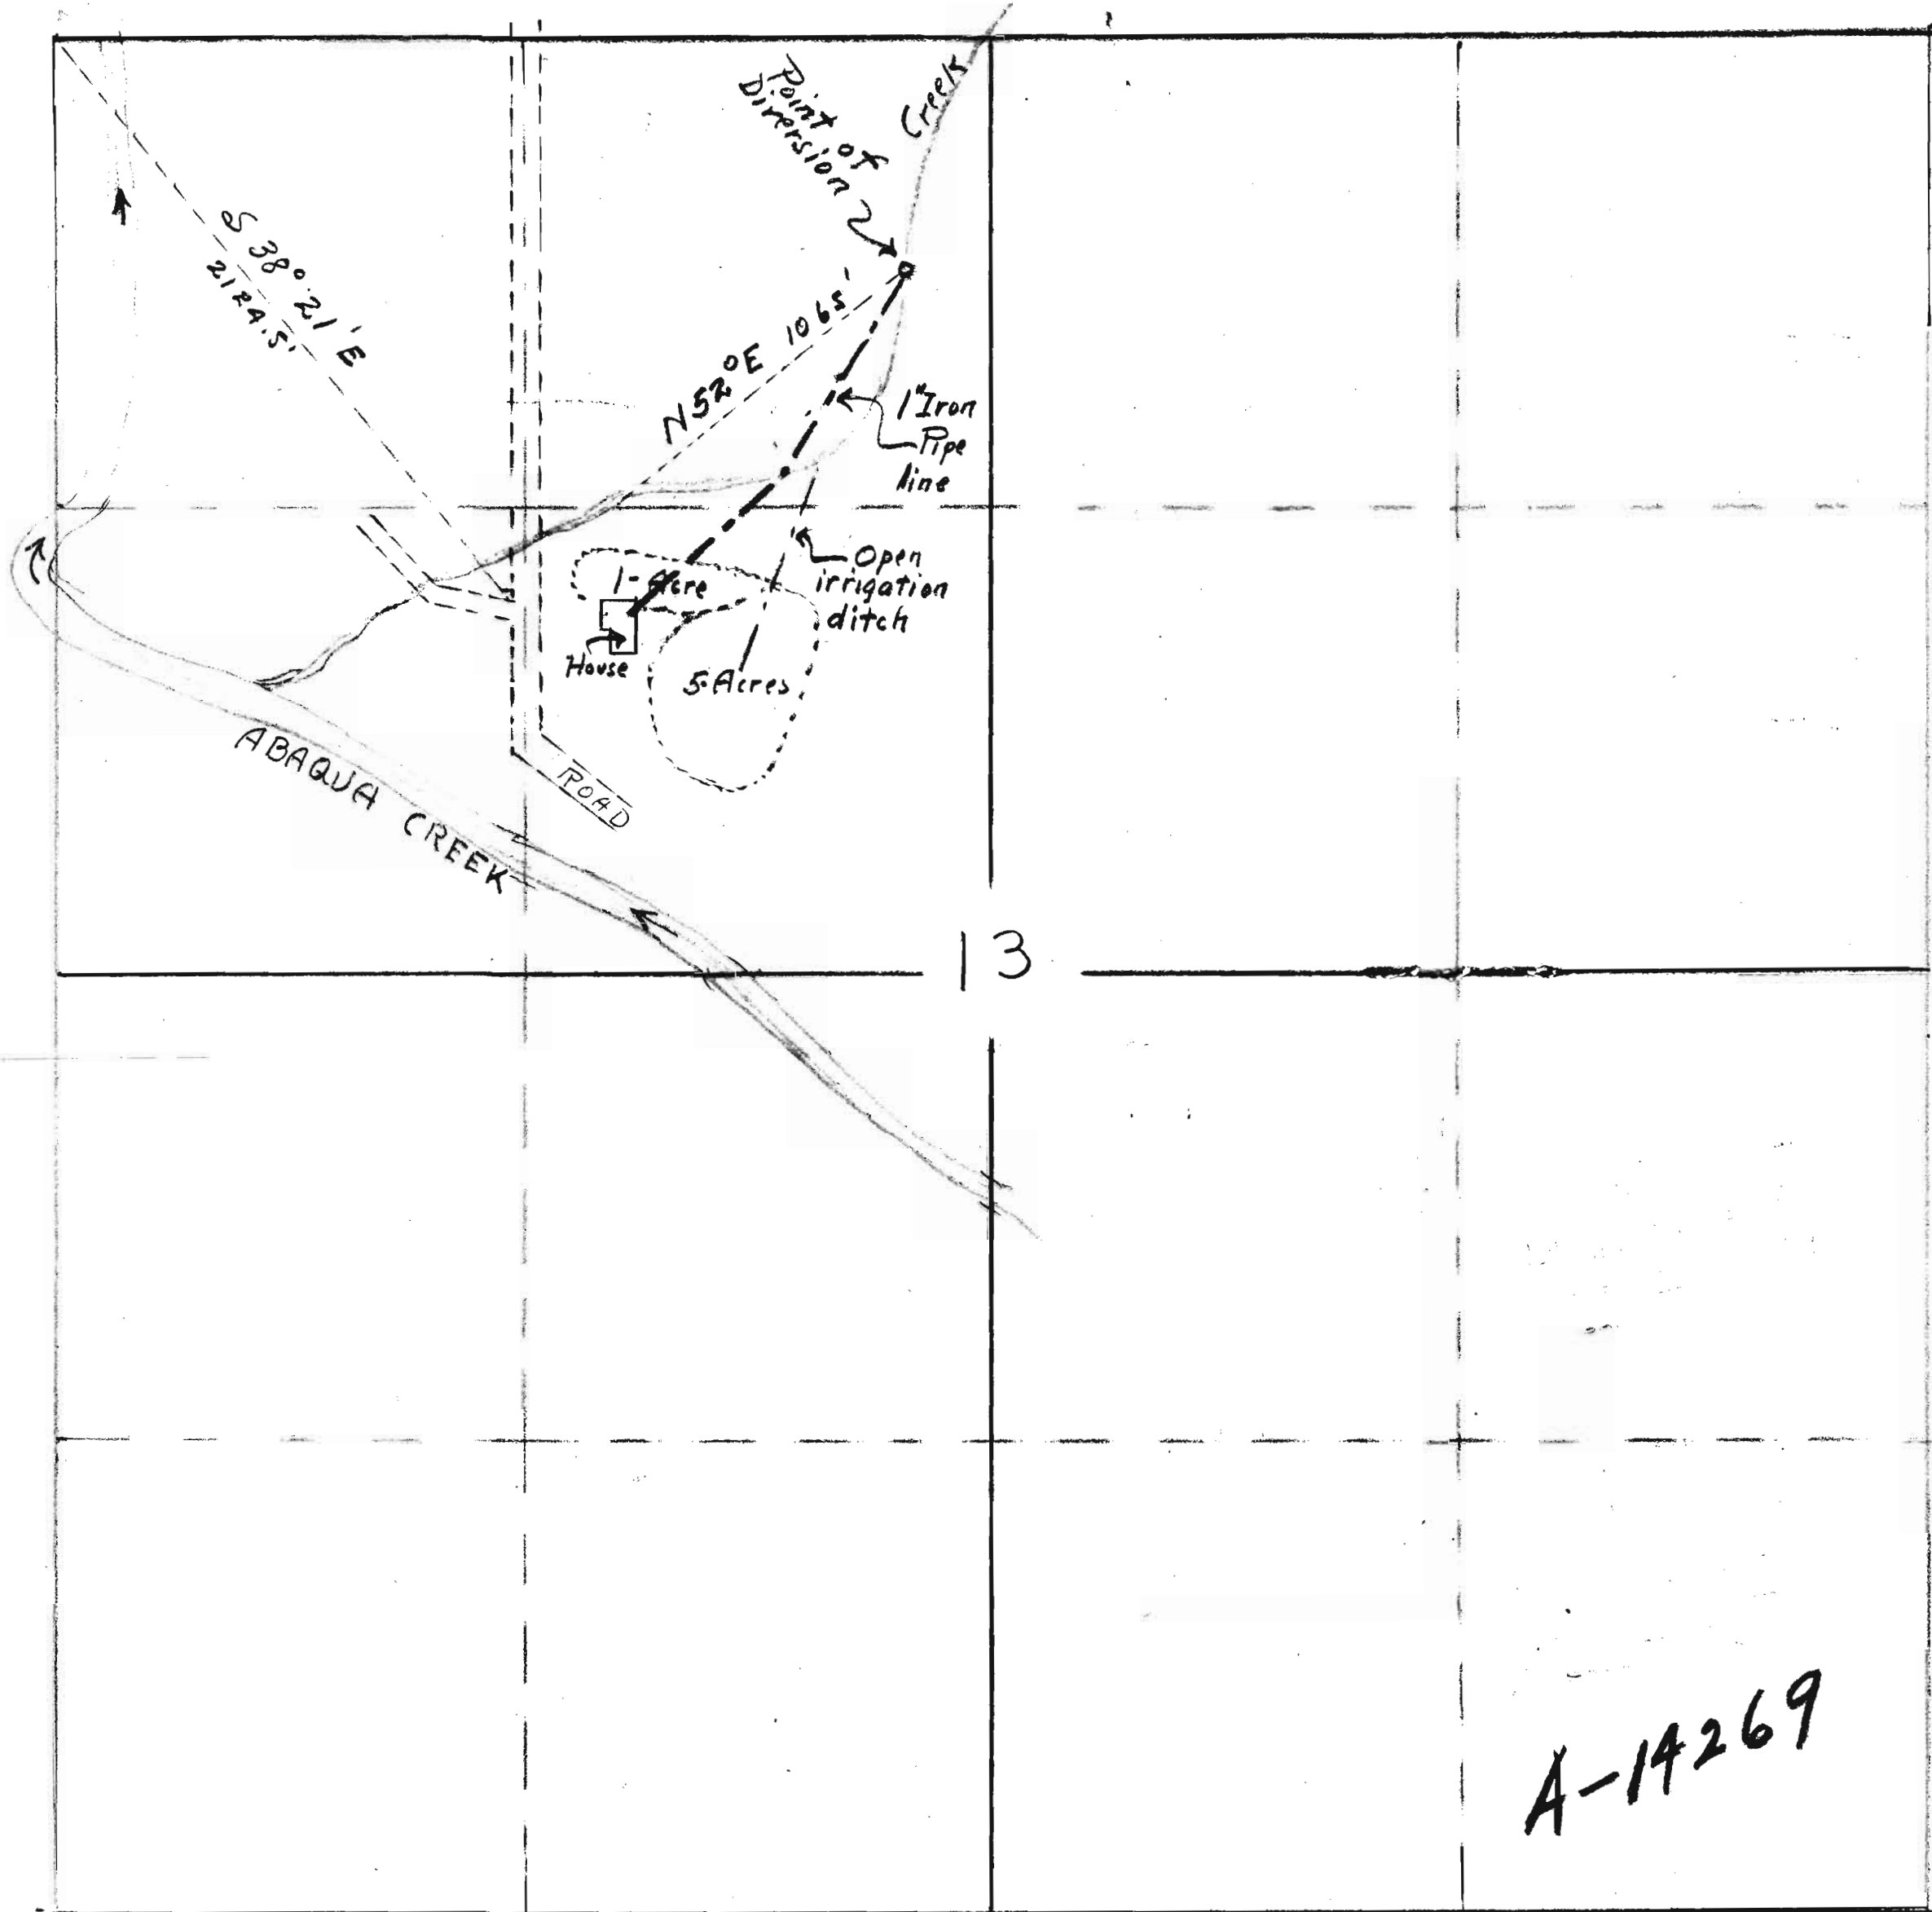

13

E.

A-14269

TOWNSHIP 7 S RANGE 1 E W.M.

APPLICATION of
TROY FITZGERELL