


SECTION

3  
4

TOWNSHIP 35 S, RANGE 8

Permit: S 10344  
Volume: 4A  
Strm: N FK GALICE CR  
Trib: GALICE CR  
Priority: 10/06/31

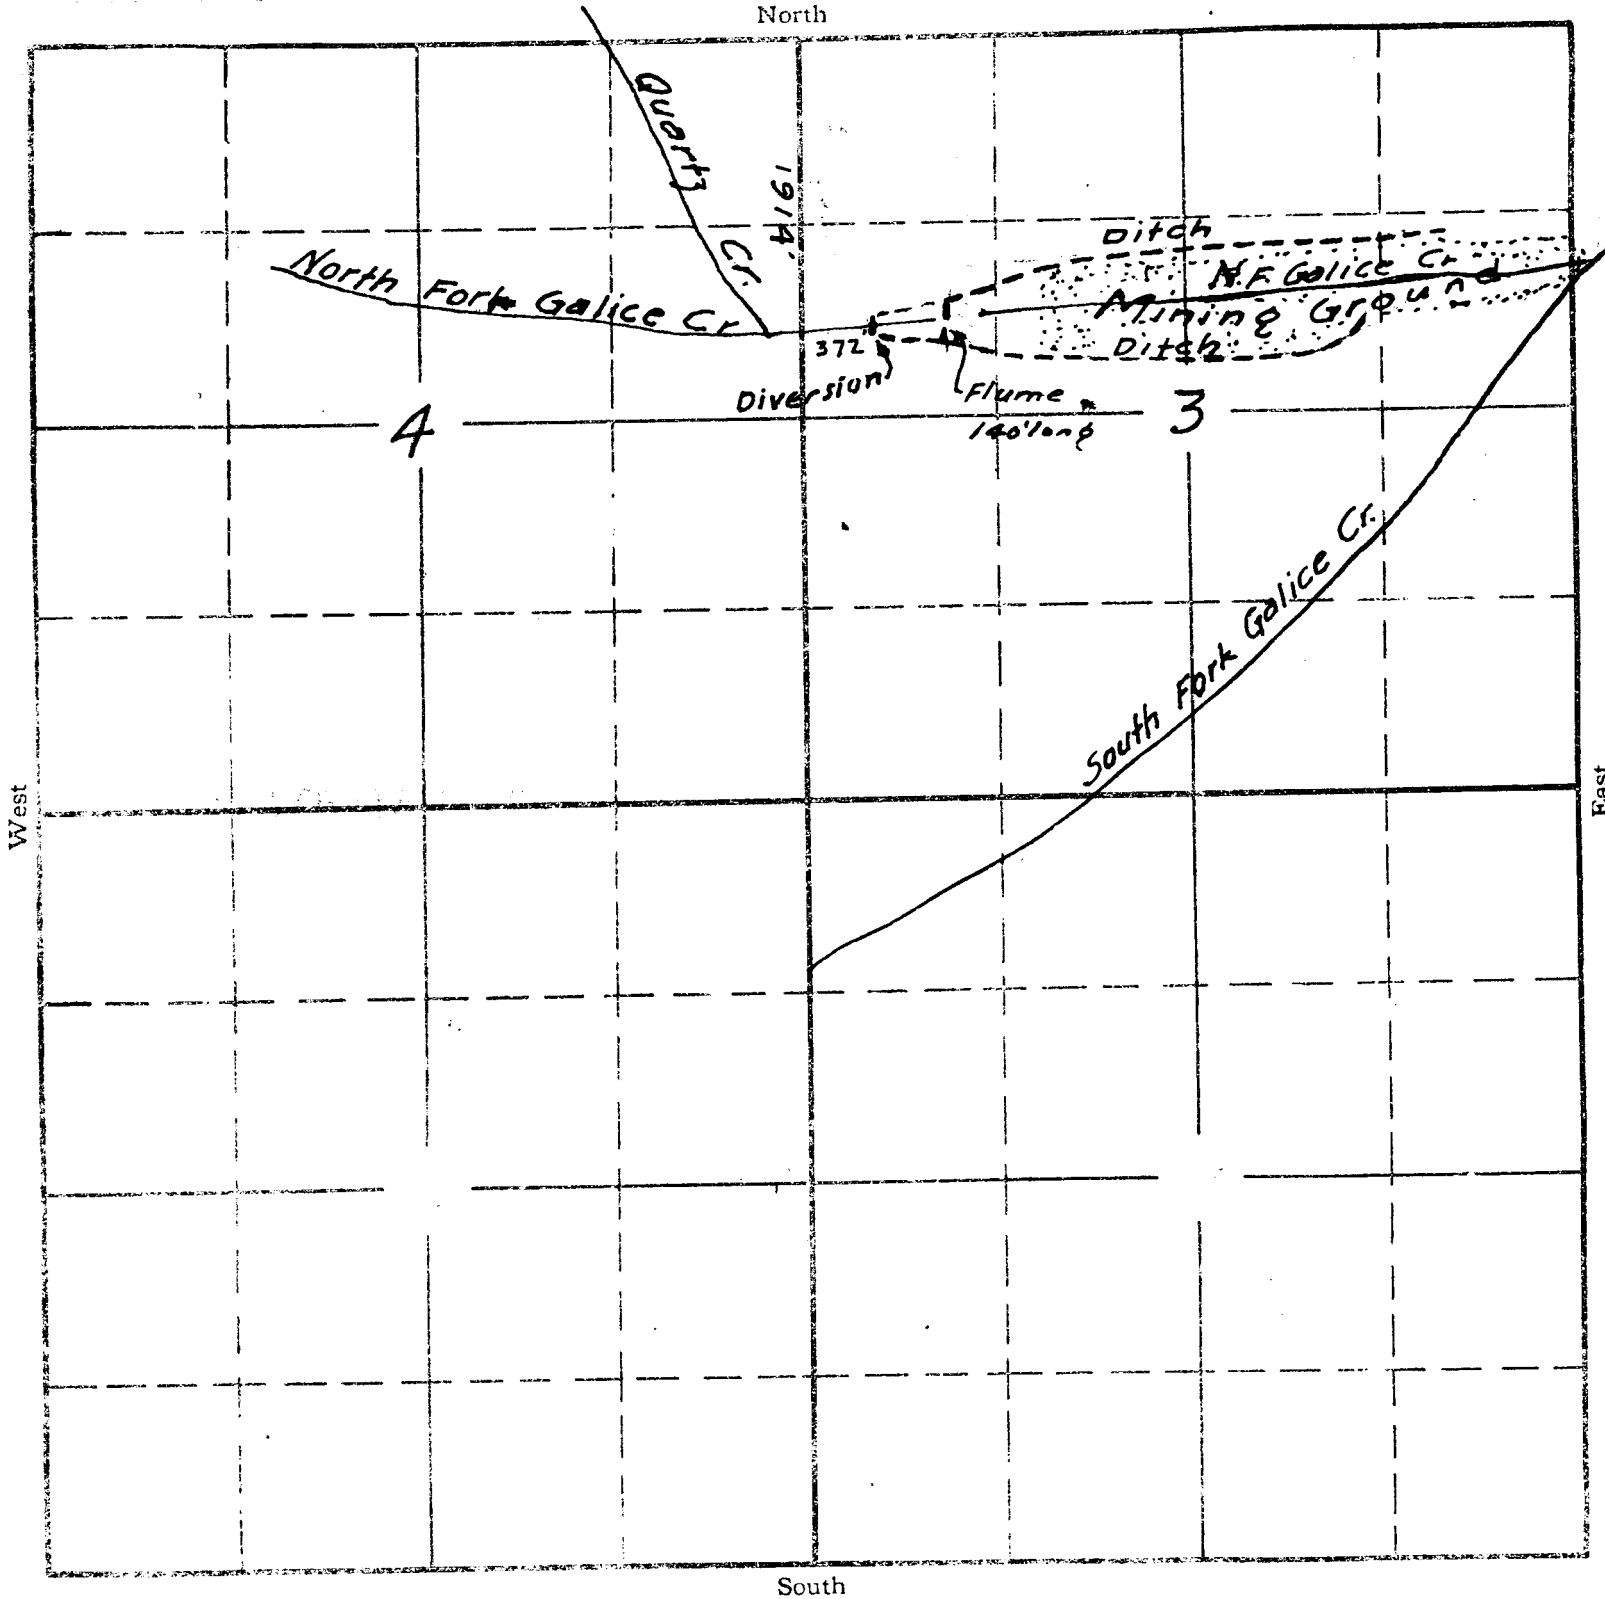

APPLICATION No. 14284  
PERMIT No. 1044