


Sec. 35

Tr. 35 S.

R. 7 W.

W.M.

Permit: S 10354  
Volume: 1  
Strm: ROGUE R  
Trib: PACIFIC OCEAN  
Priority: 9/11/31

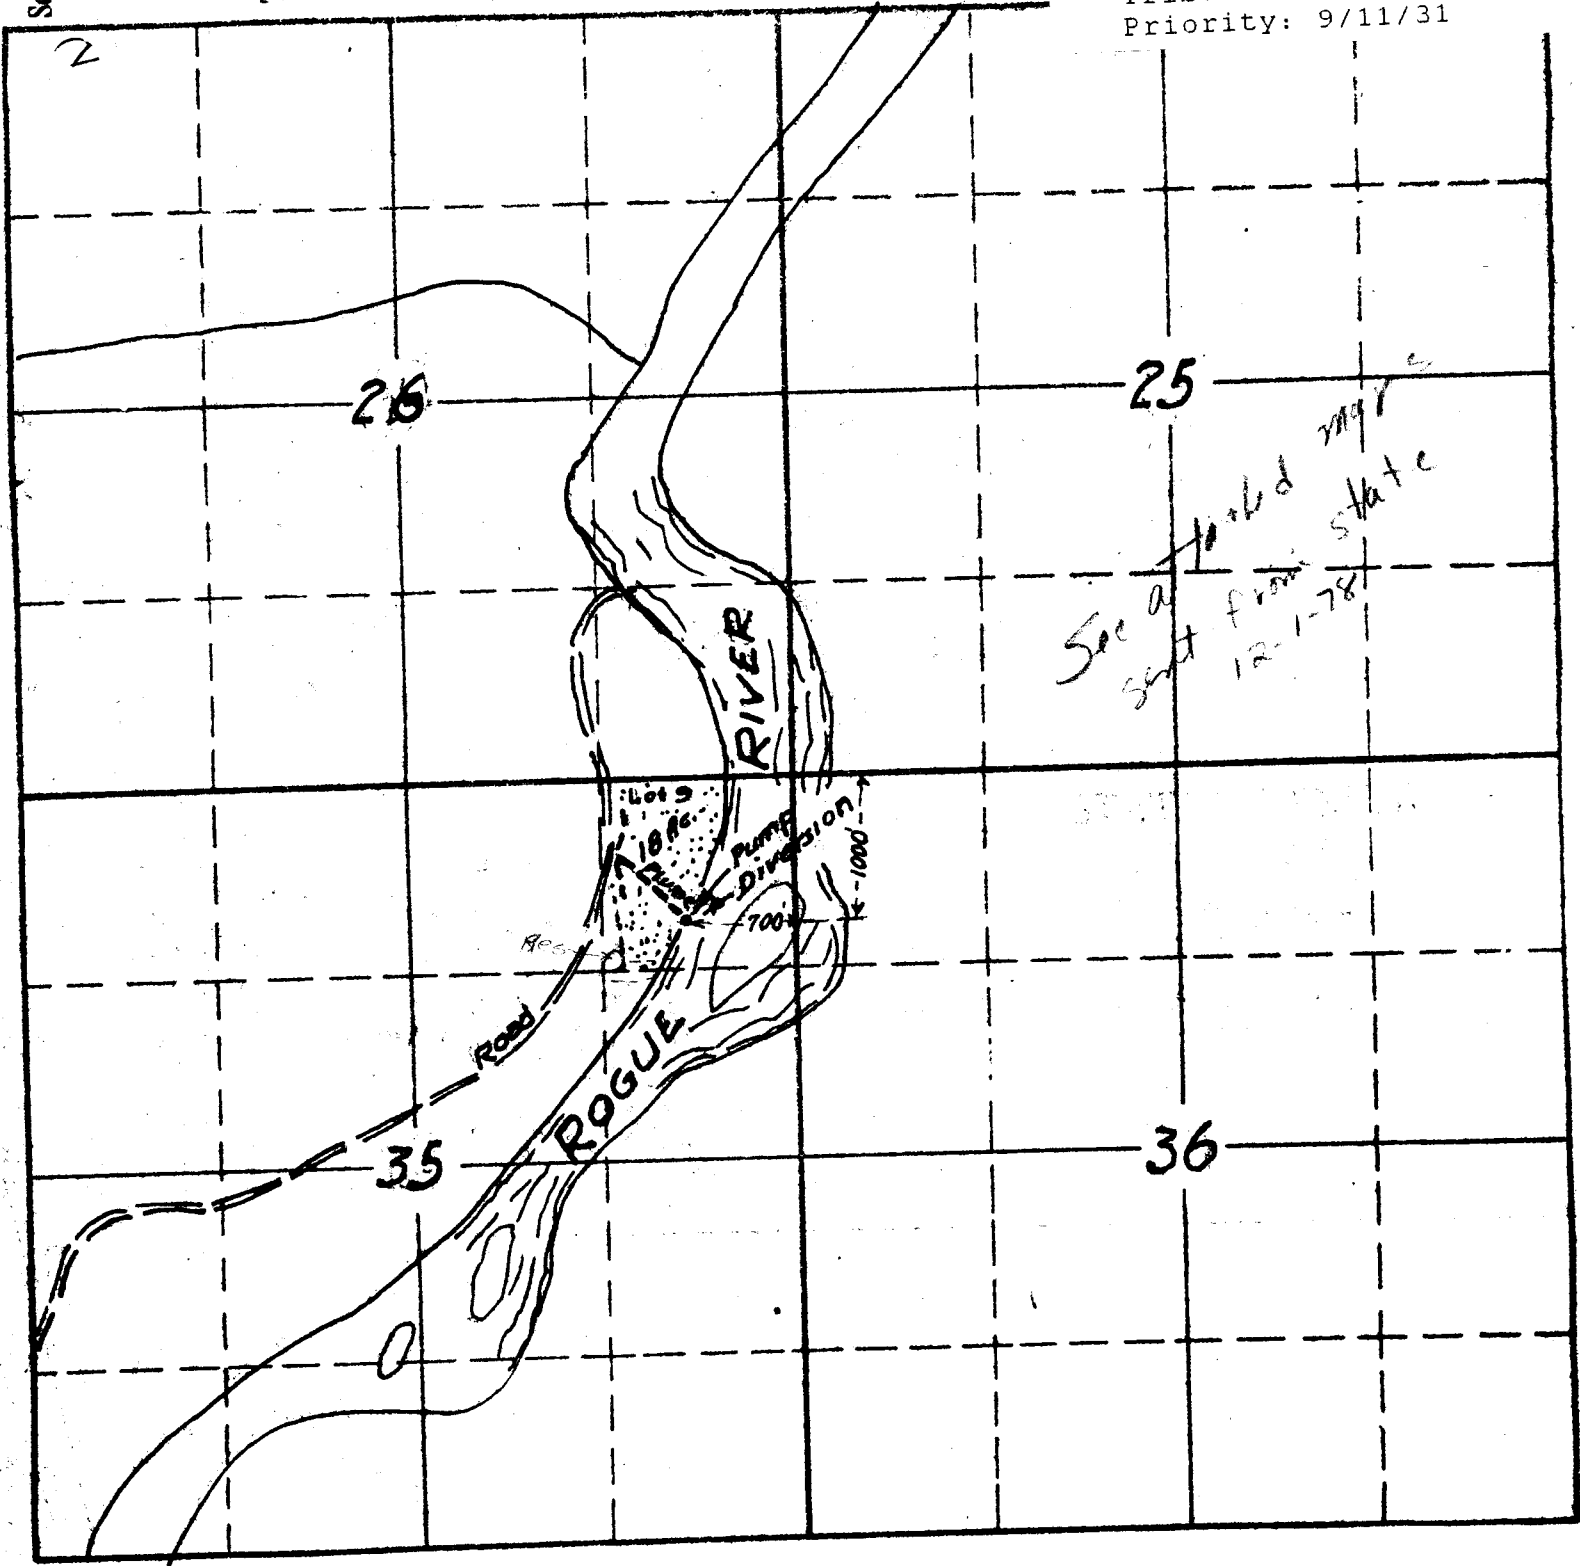

Application No. 14311  
Permit No. 10354