


SECTION

TOWNSHIP 1N, RANGE 1W, W. M.

North

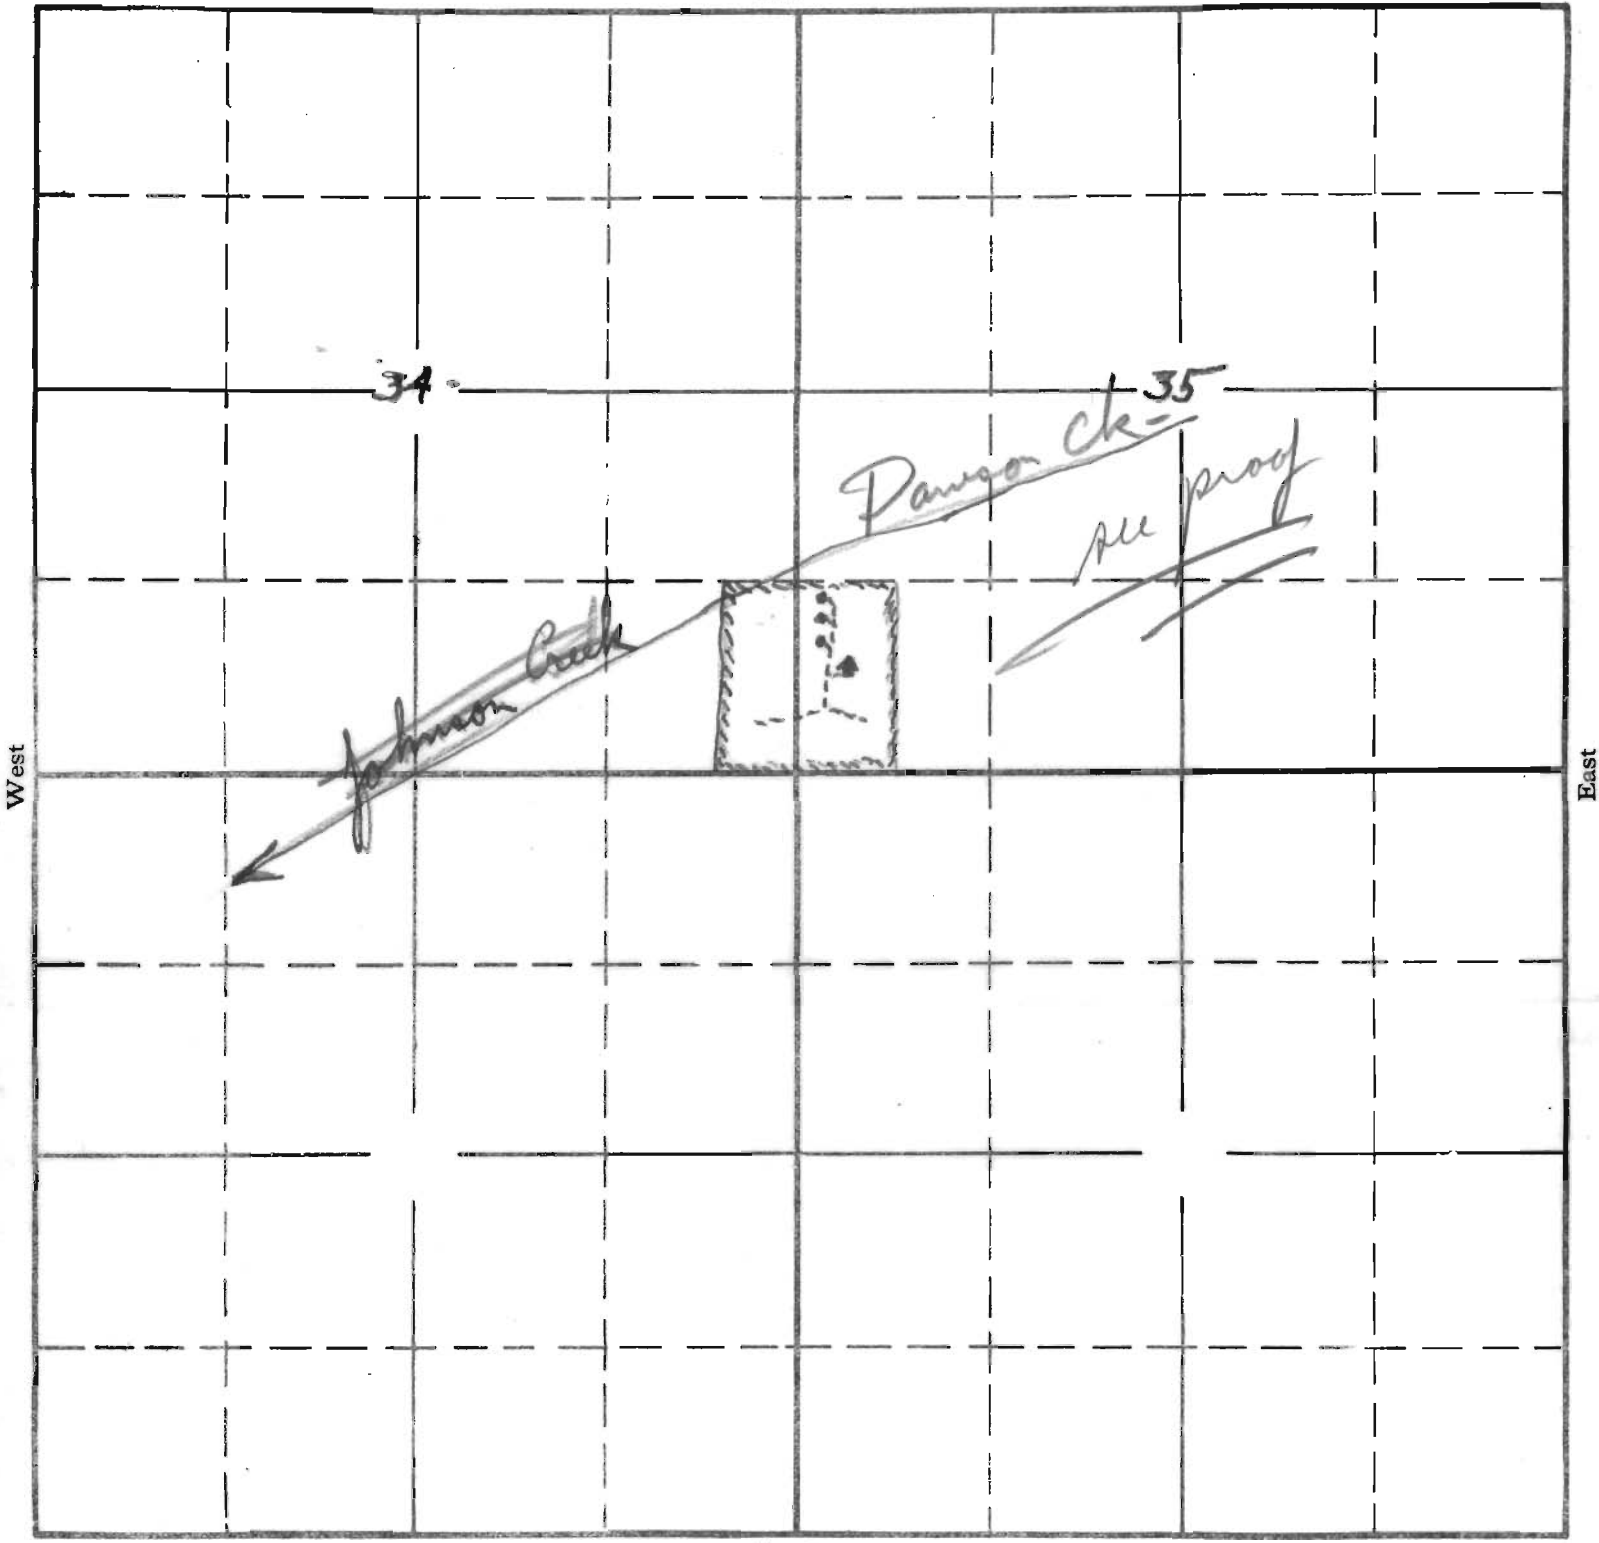

South

APPLICATION No. 14347

PERMIT No. 10375