


SECTION

TOWNSHIP 13S, RANGE 11W, W. M.

North

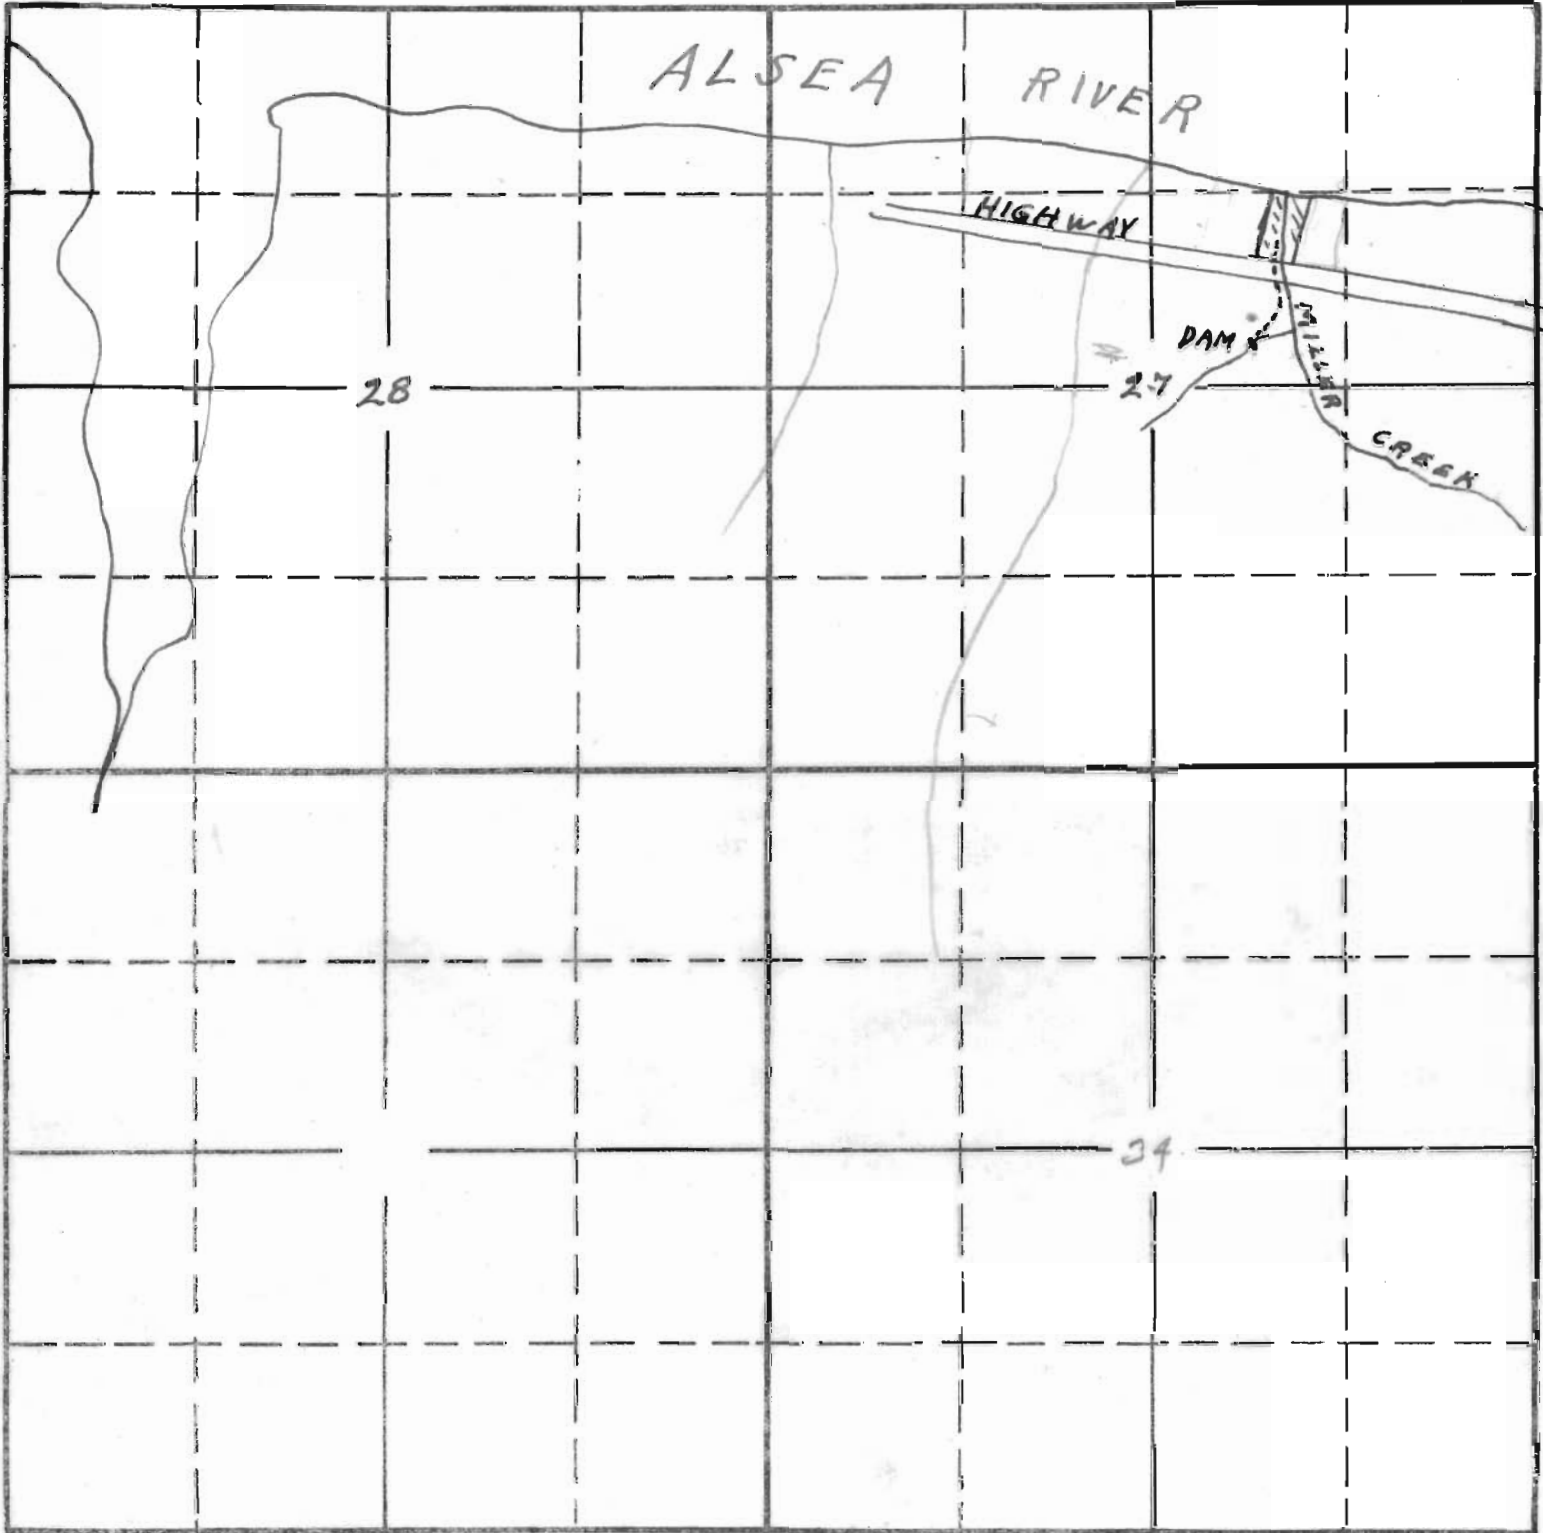

West

East

South

APPLICATION No. 14292

PERMIT No. 10415