


SECTION

TOWNSHIP 6S, RANGE 7W, W. M.

North

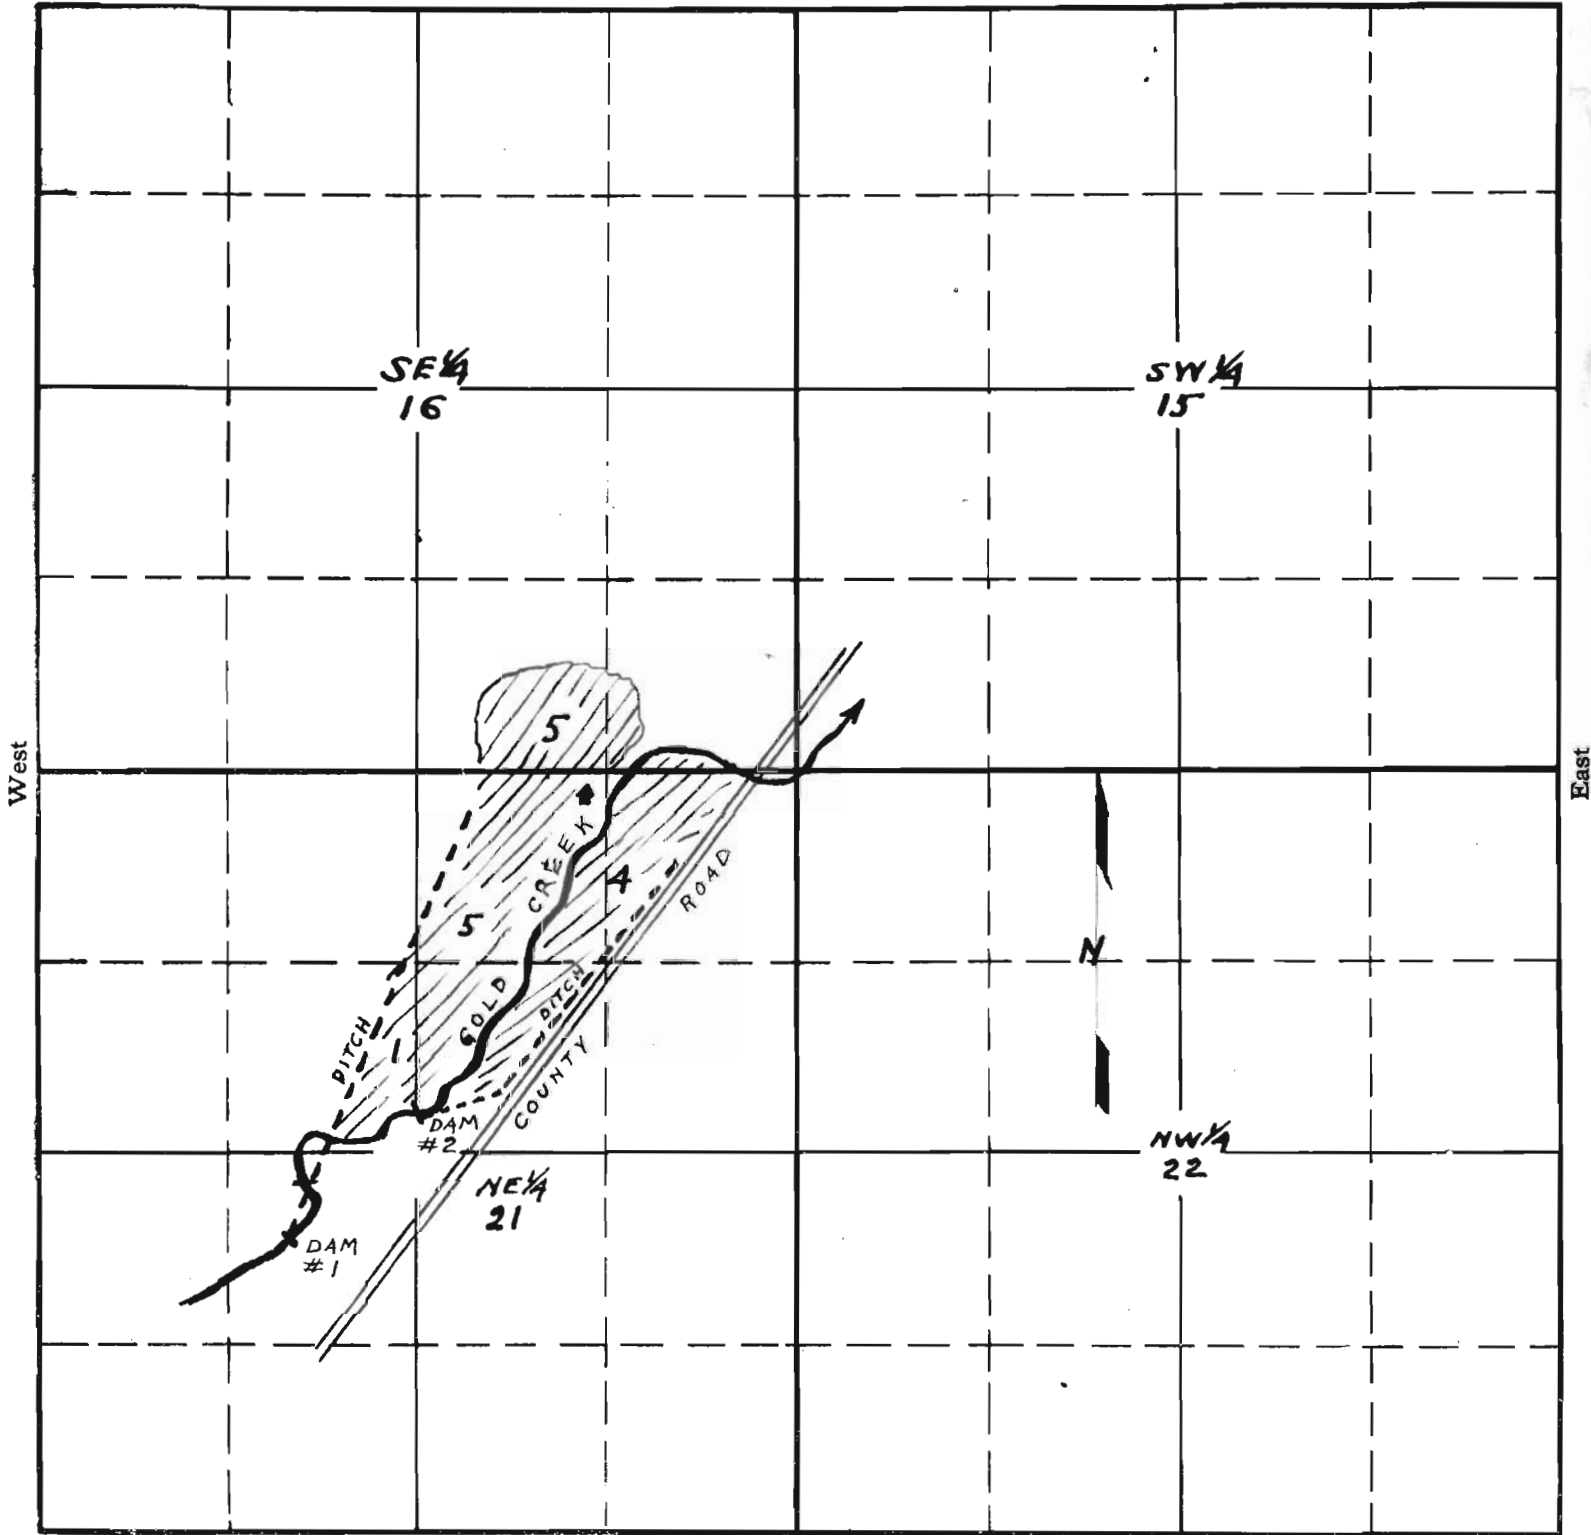

DRAWN IN S

South

APPLICATION No. 14417
 PERMIT No. 10437


SECTION

TOWNSHIP 6.5, RANGE 7W, W. M.

North

West

East

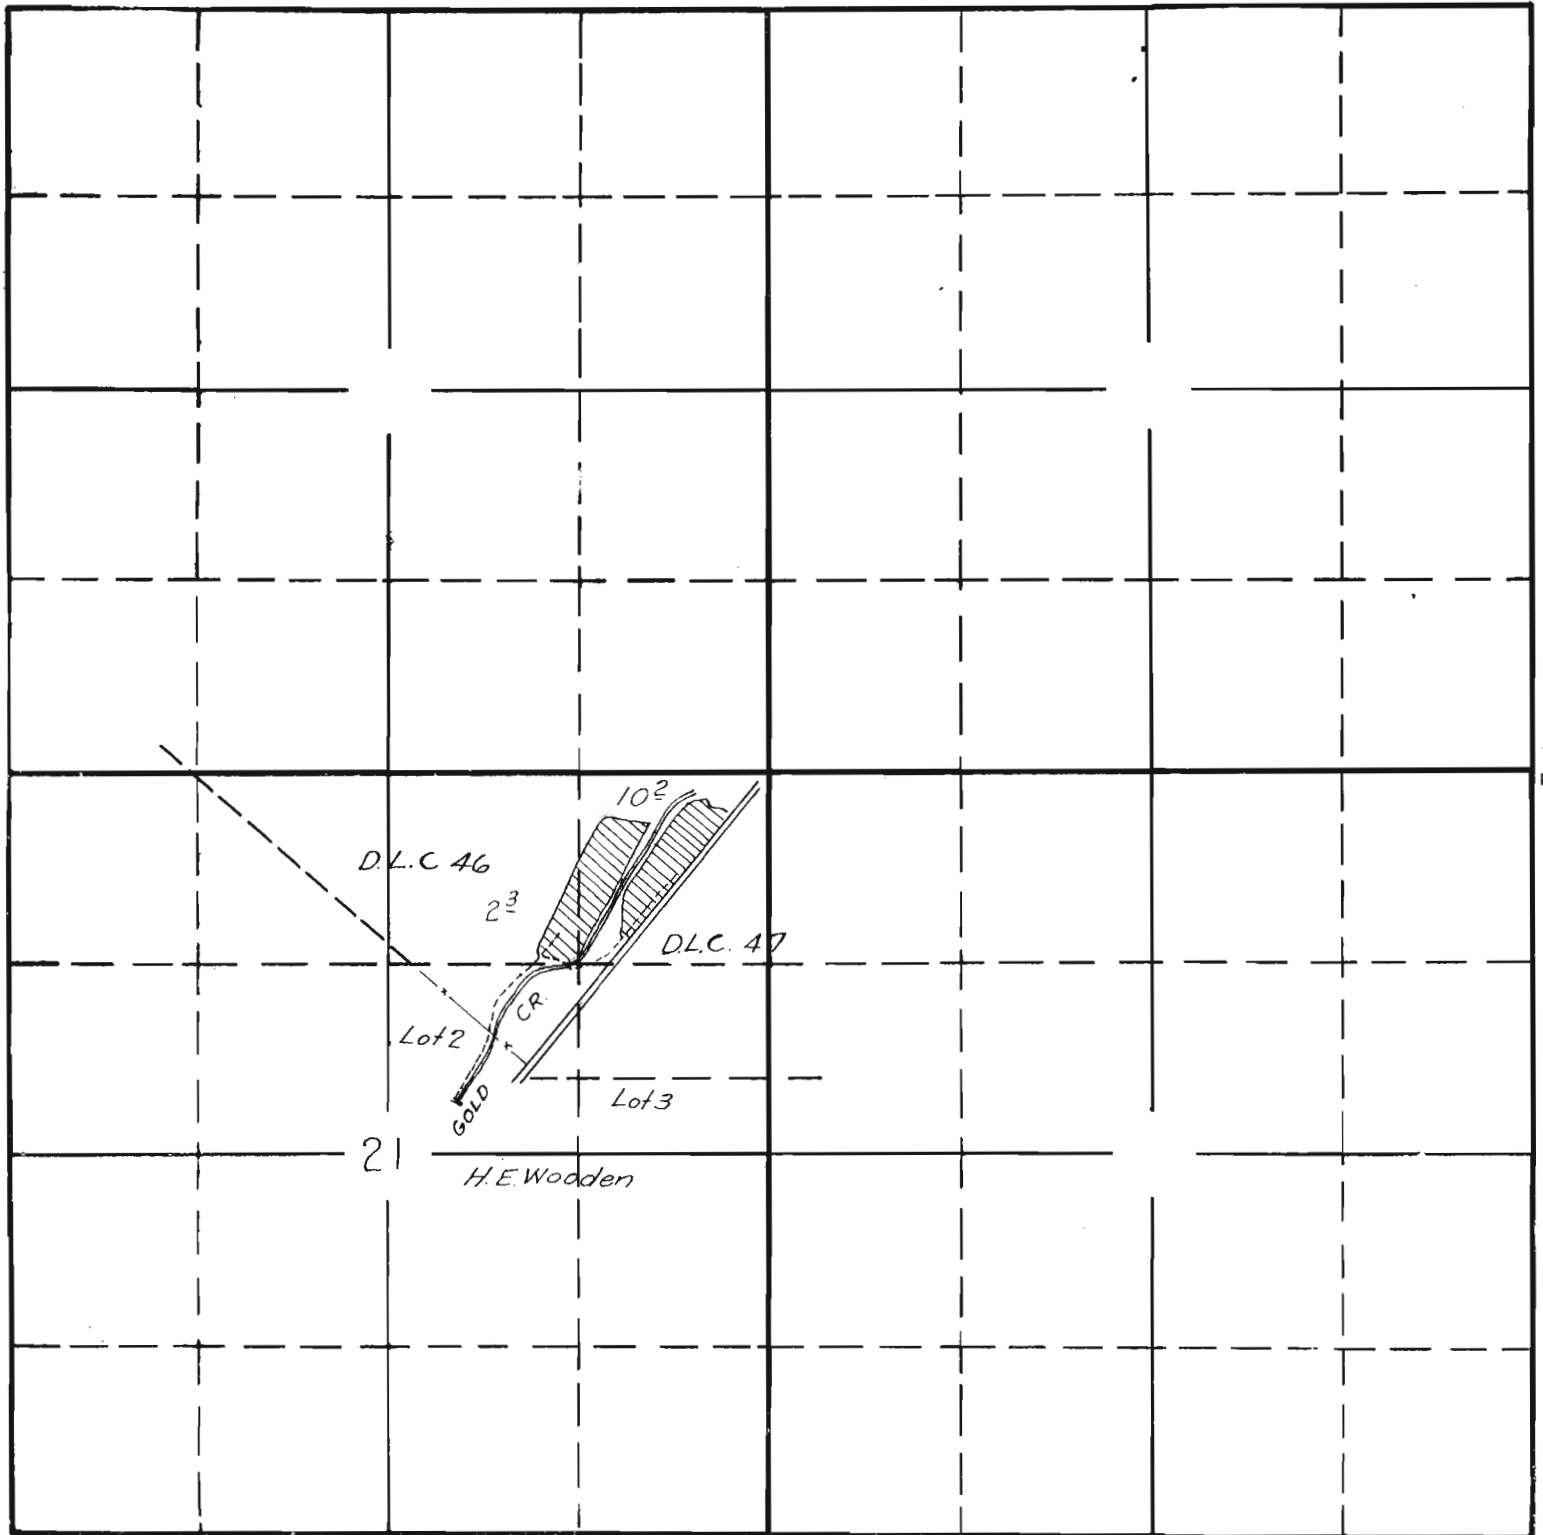

South

APPLICATION No. 14417
PERMIT No. 10437

from with proof