


SECTION

1

2

TOWNSHIP 36 S; RANGE 7 W, W. M.

North

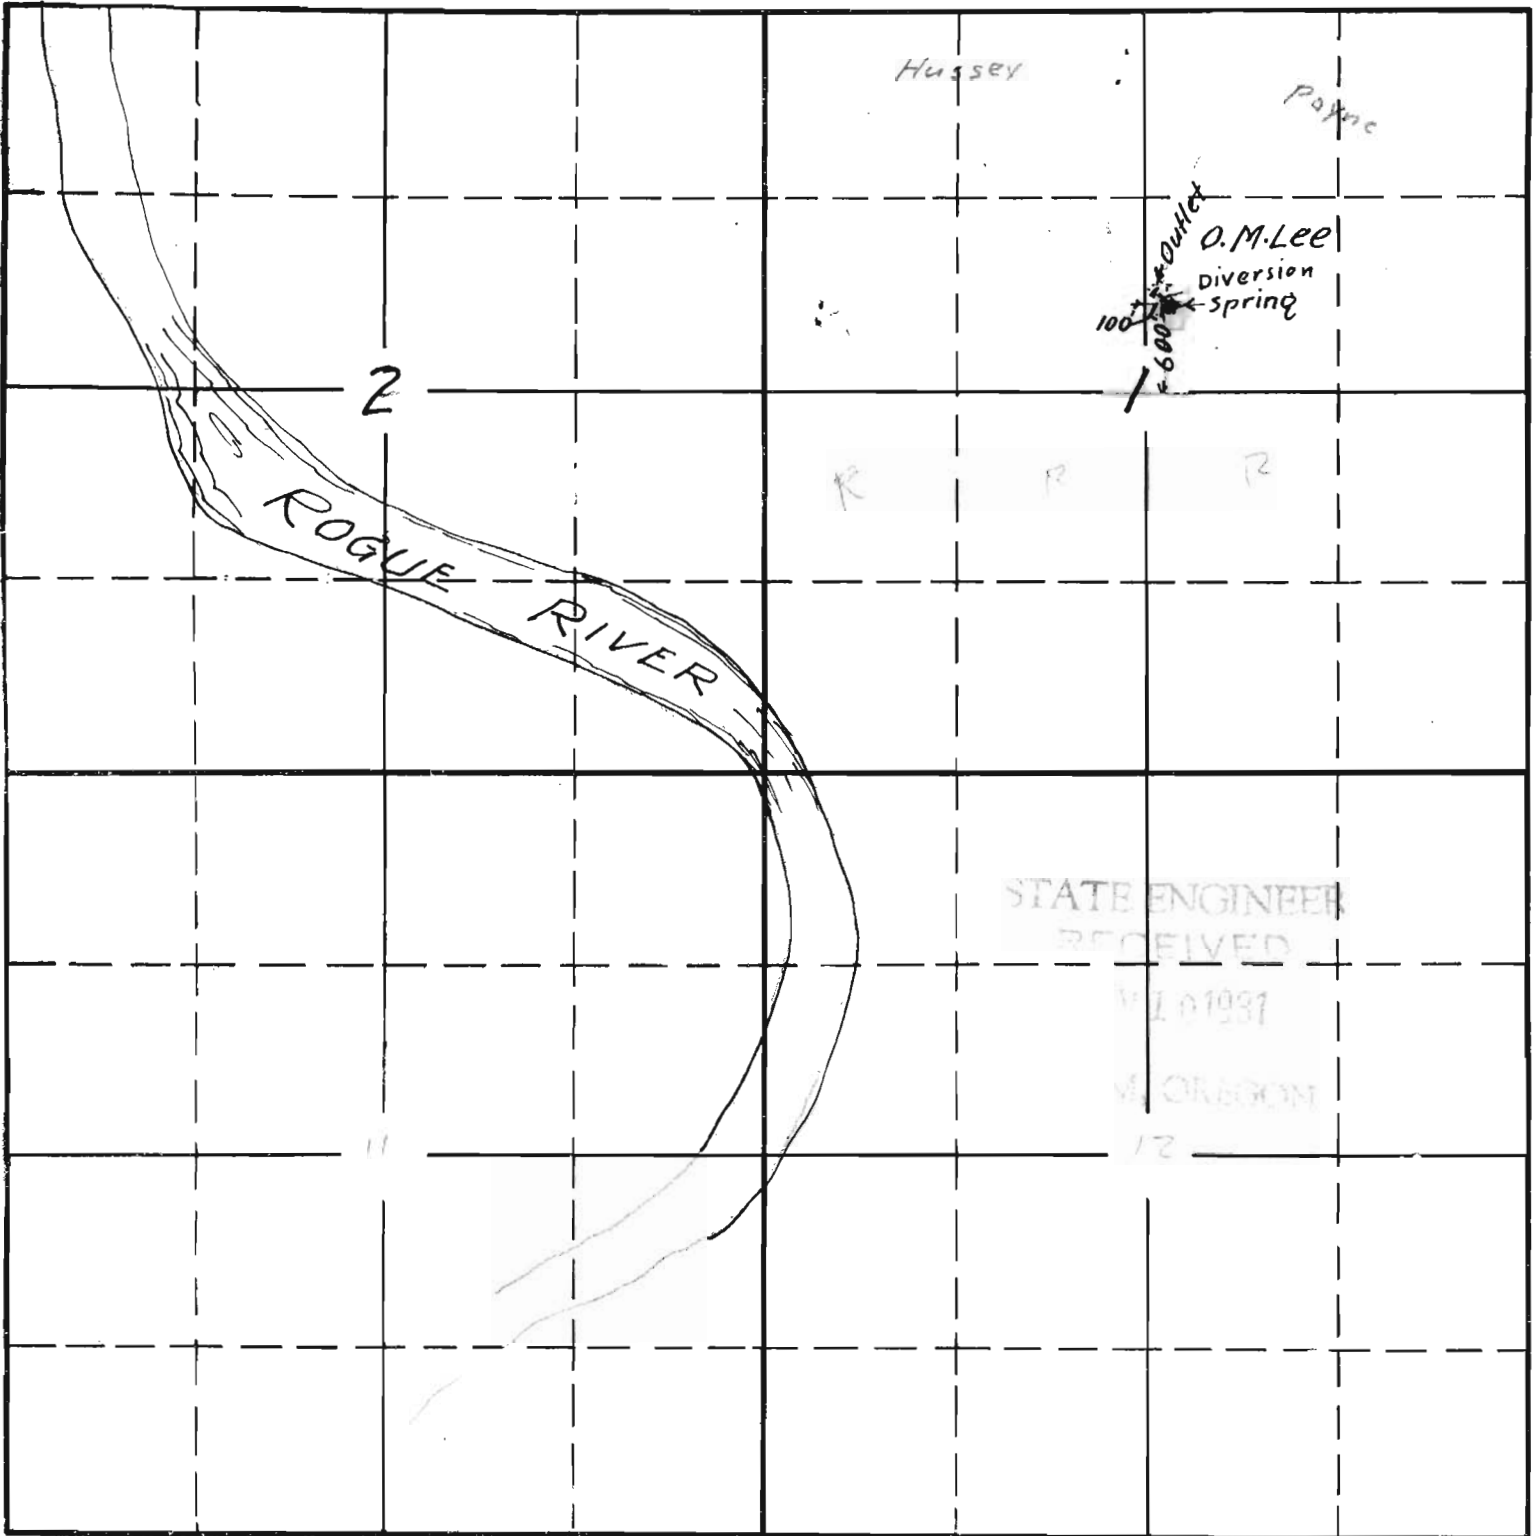

South

APPLICATION No. 14407
PERMIT No. 10449