


Application No. 14447

Permit No. 10467

T. 37 S., R. 9 W., W.M.

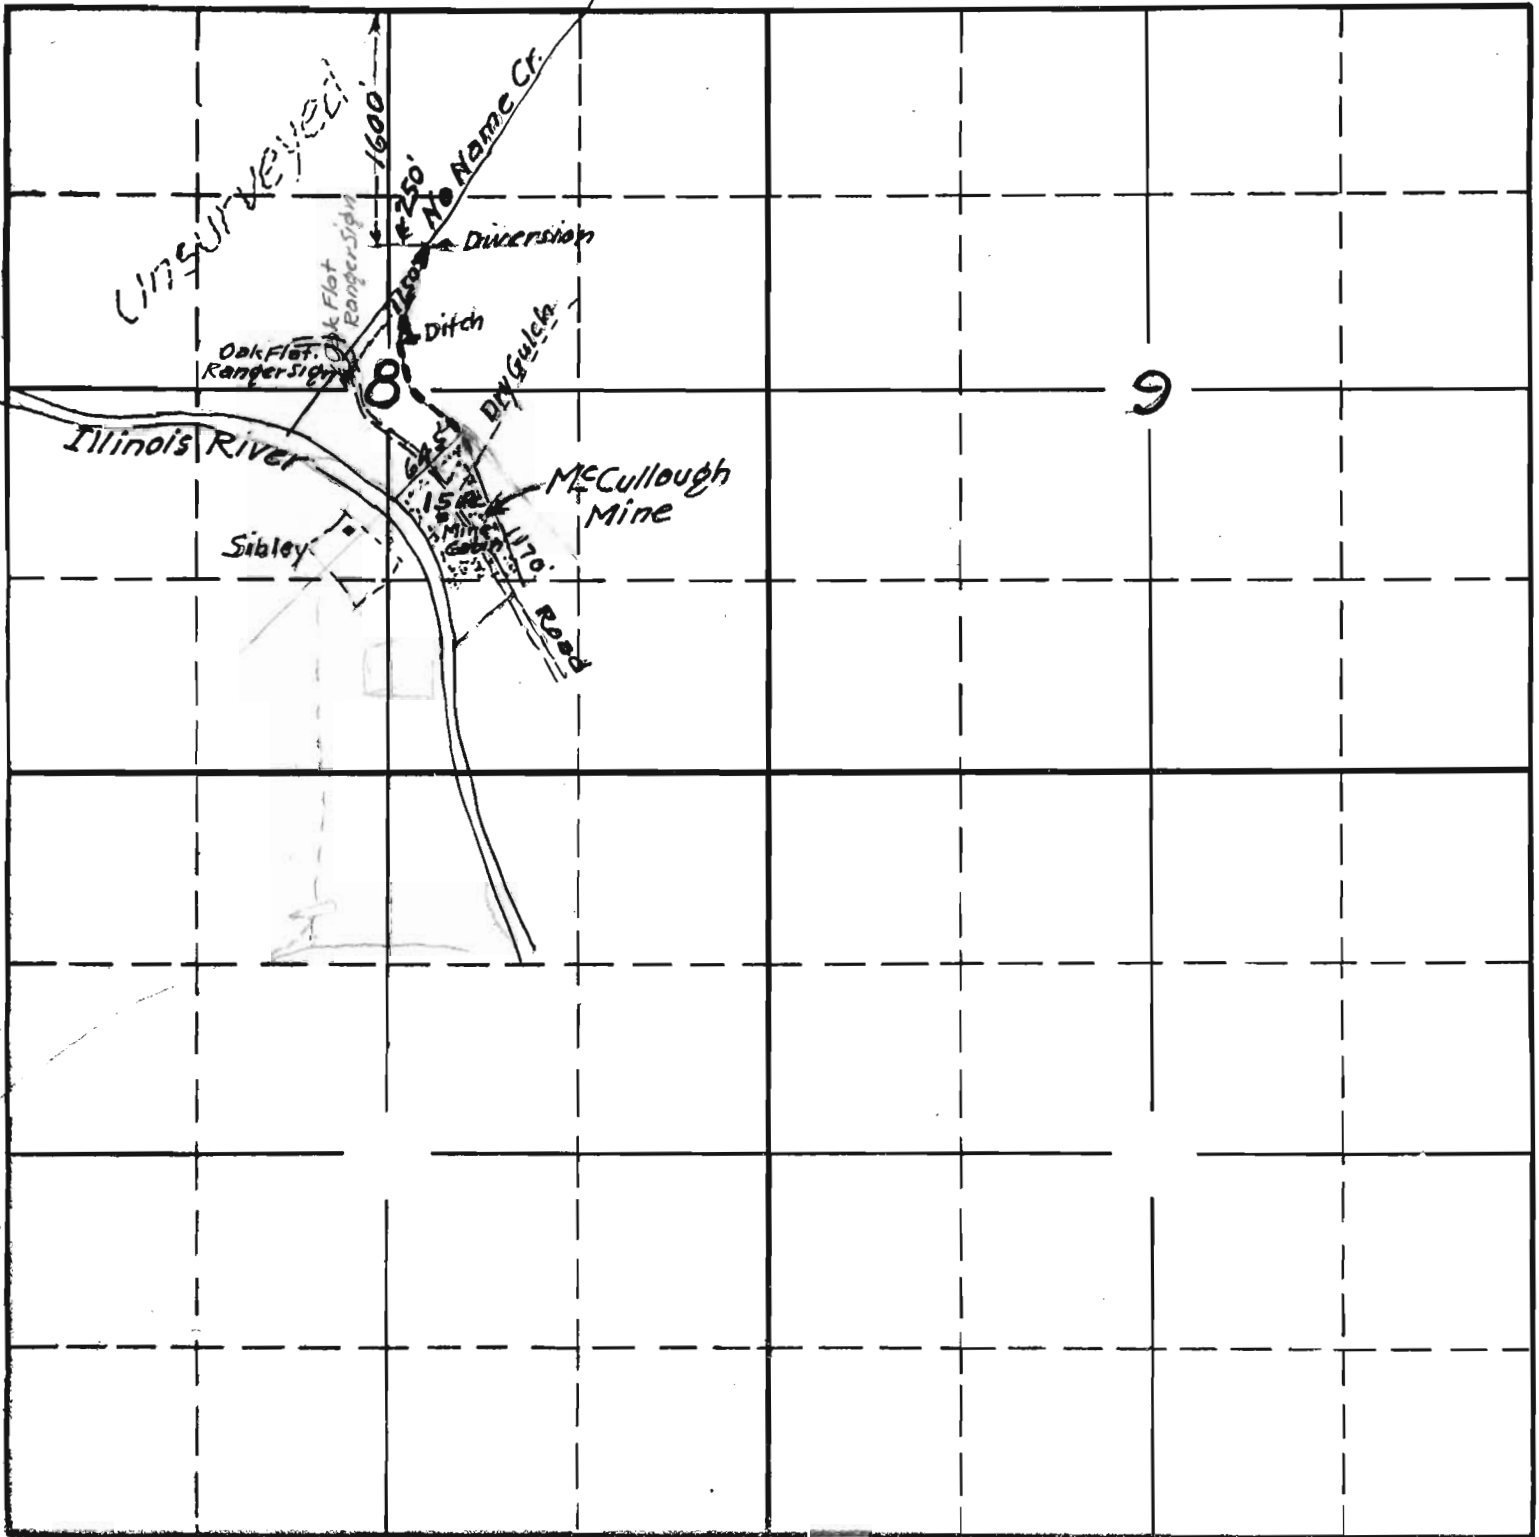

Sec. _____
Tp. _____
R. _____