

SECTION

- 1
- 2
- 11
- 12

TOWNSHIP 16 S., RANGE 29 E., W. M.

North

2

1

STATE ENGINEER
 RECEIVED
 JAN 19 1932
 SALEM, OREGON


11

12

3650'

1650'

900'

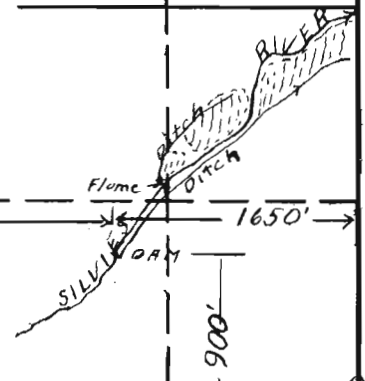

South

APPLICATION No. 14467
 PERMIT No. 10478