


Sec. 27
28
Tp. 35 S.
R. 14 W.

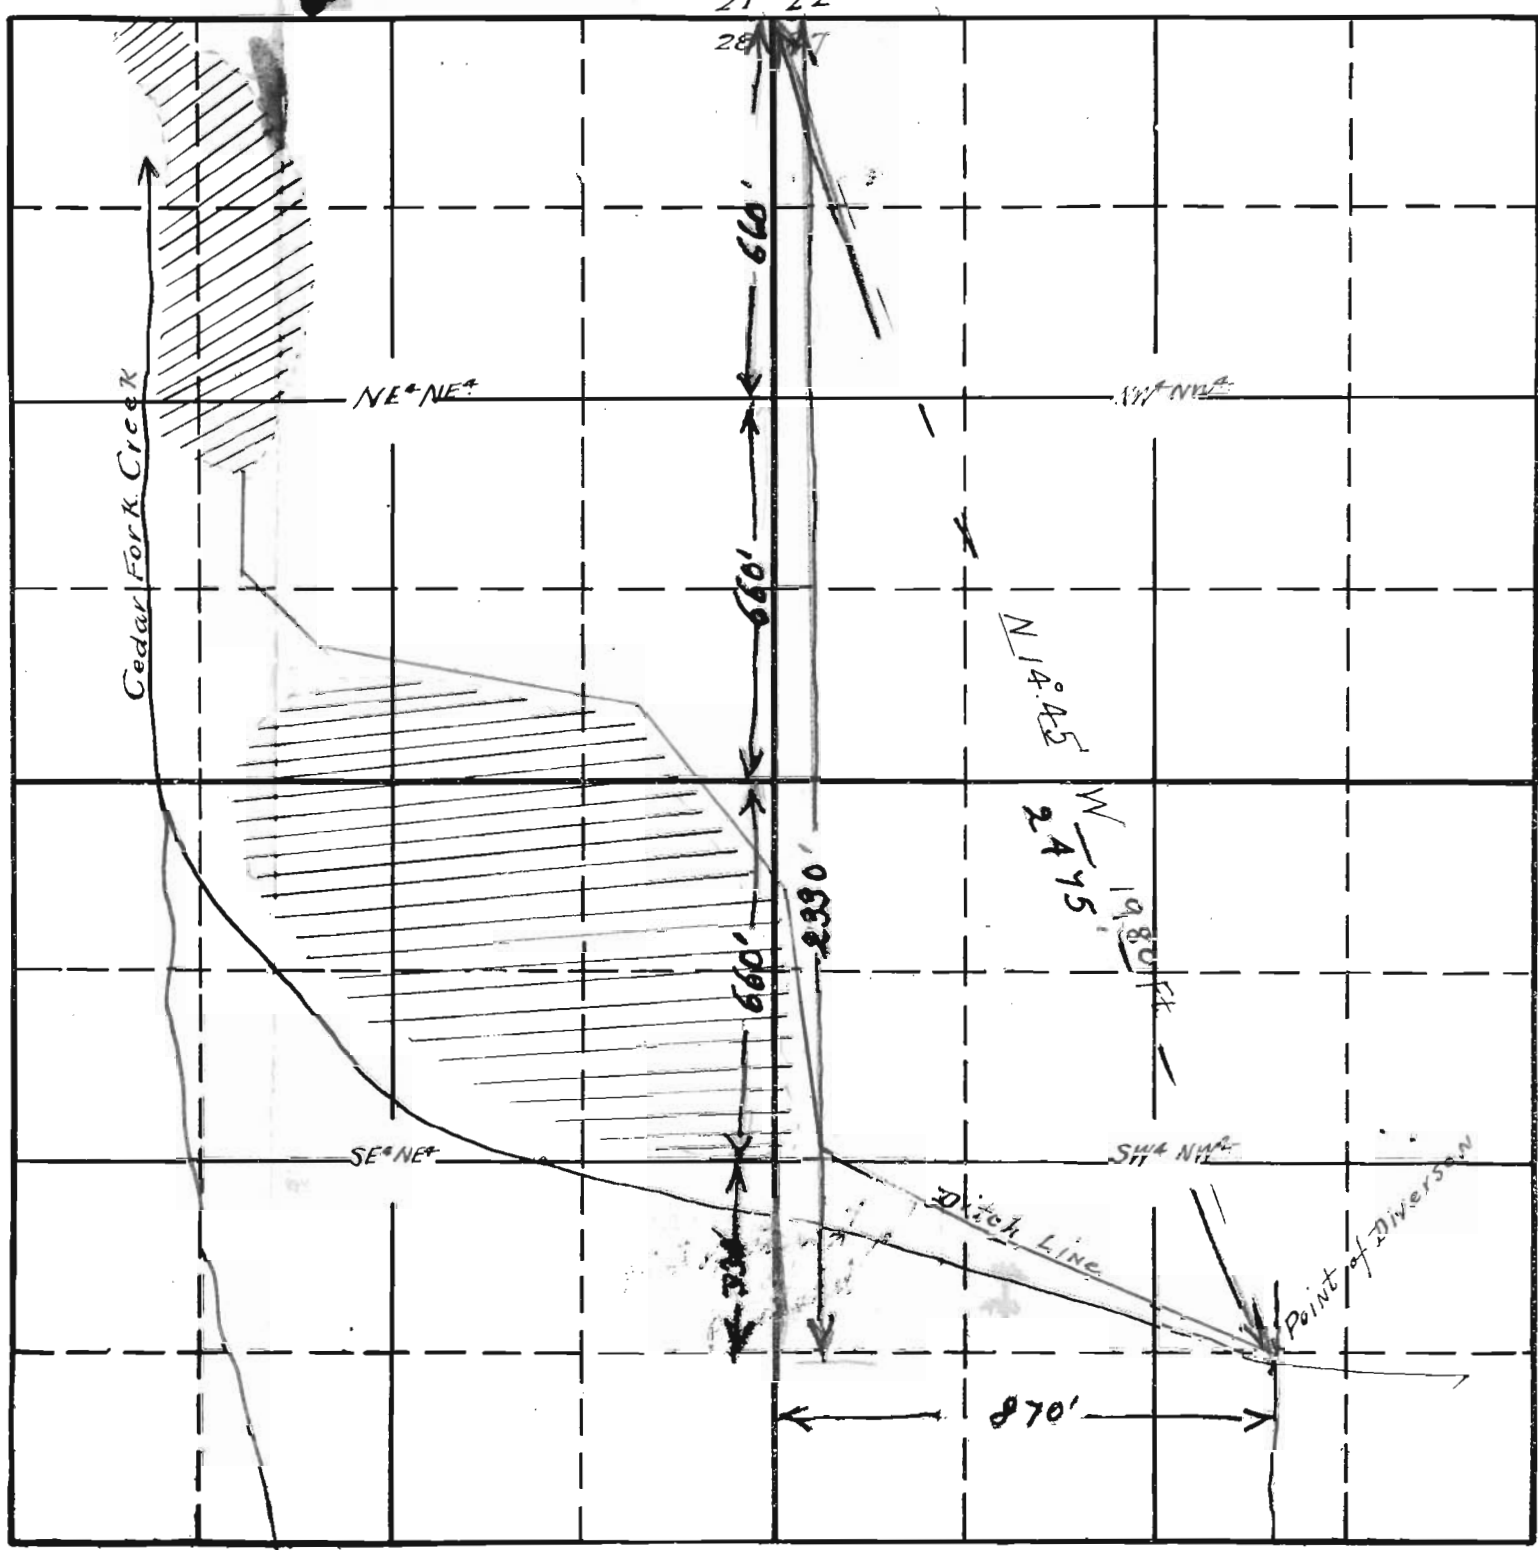

Application No. 14478
Permit No. 10499