


SECTION

8
9
16
17

TOWNSHIP 4S., RANGE 2E., W. M.

North

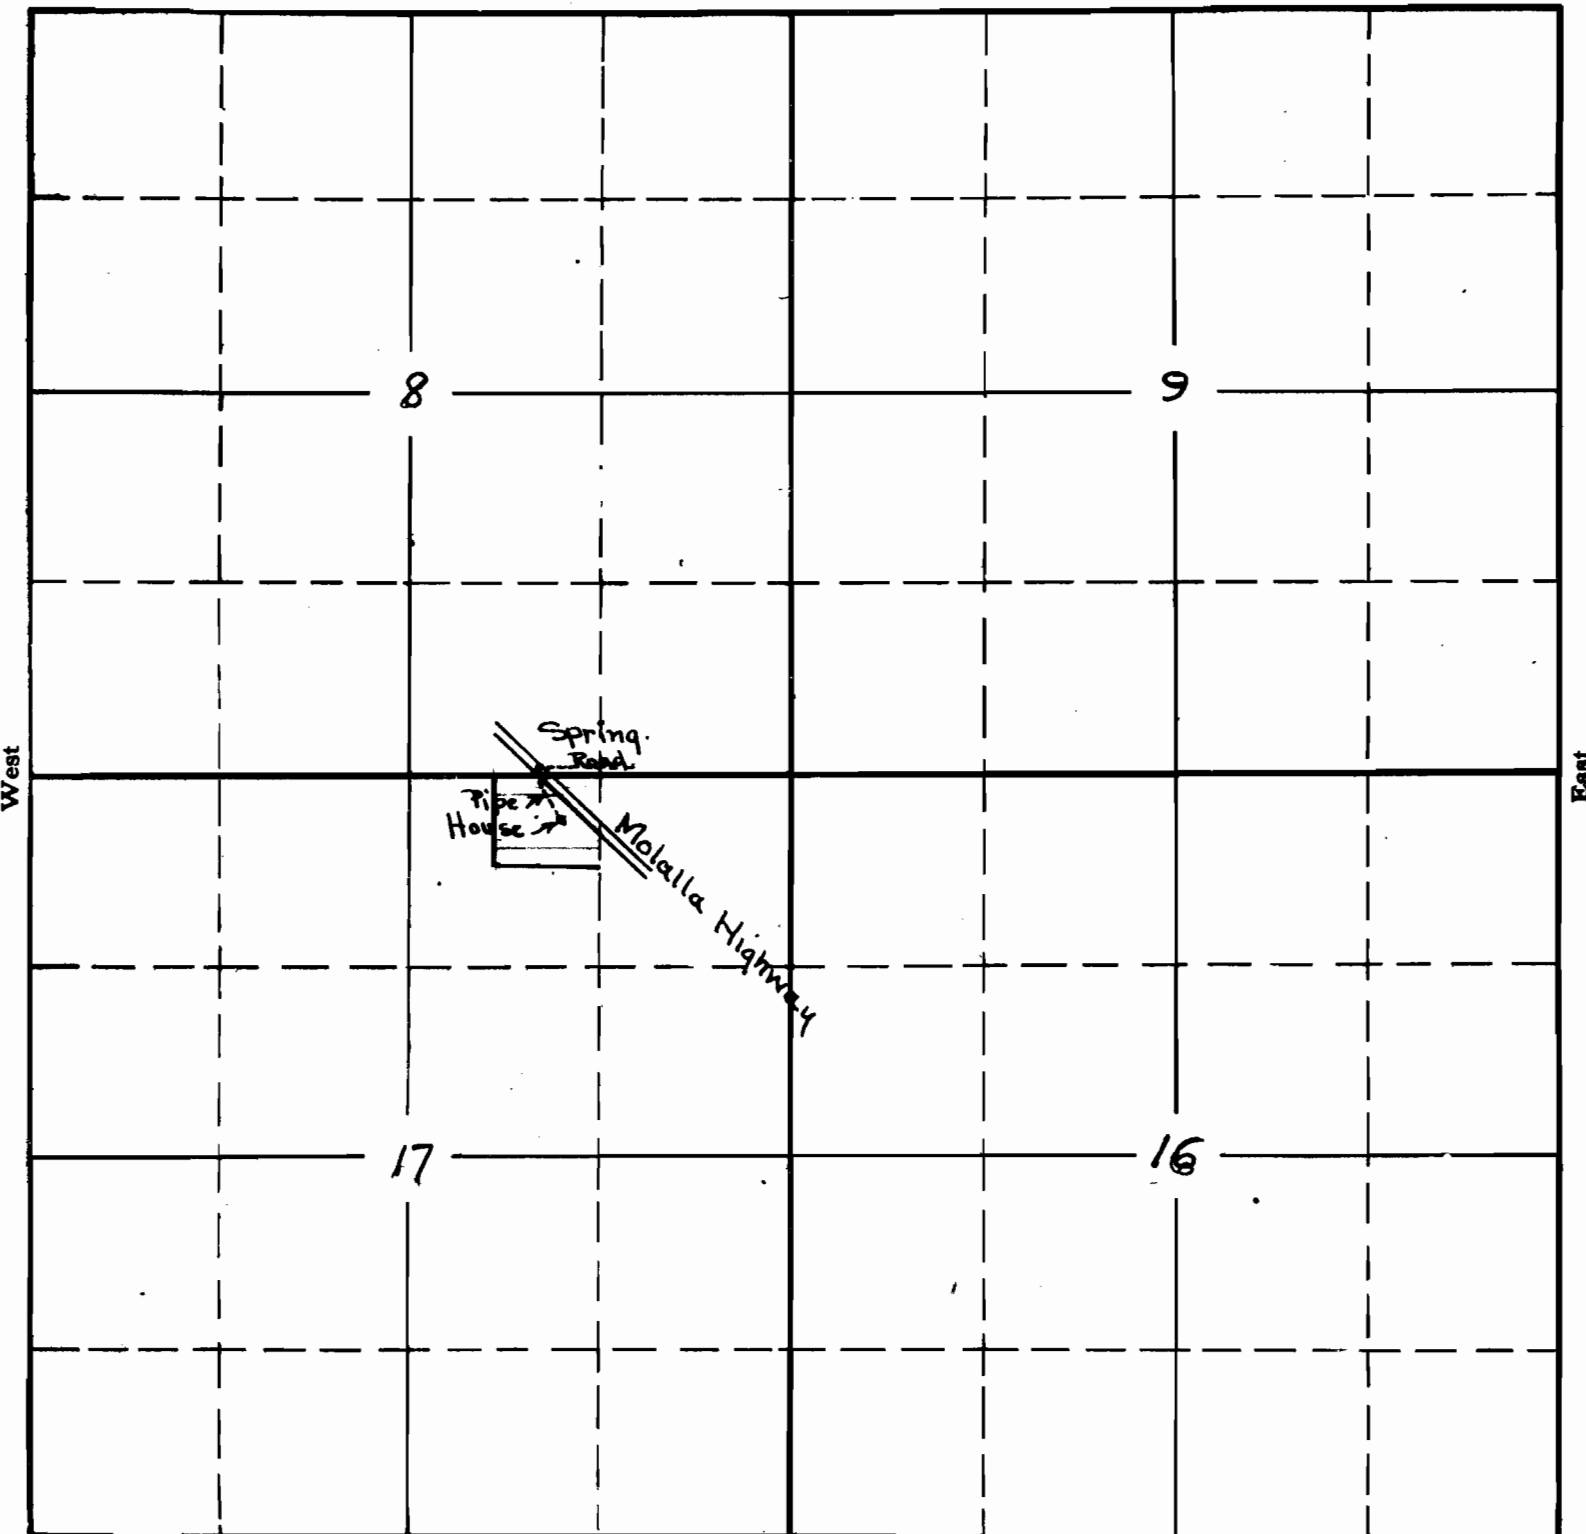

South

APPLICATION No. 14524
PERMIT No. 10526