


14

TOWNSHIP 6 S, RANGE 11 W, W. M.  
N

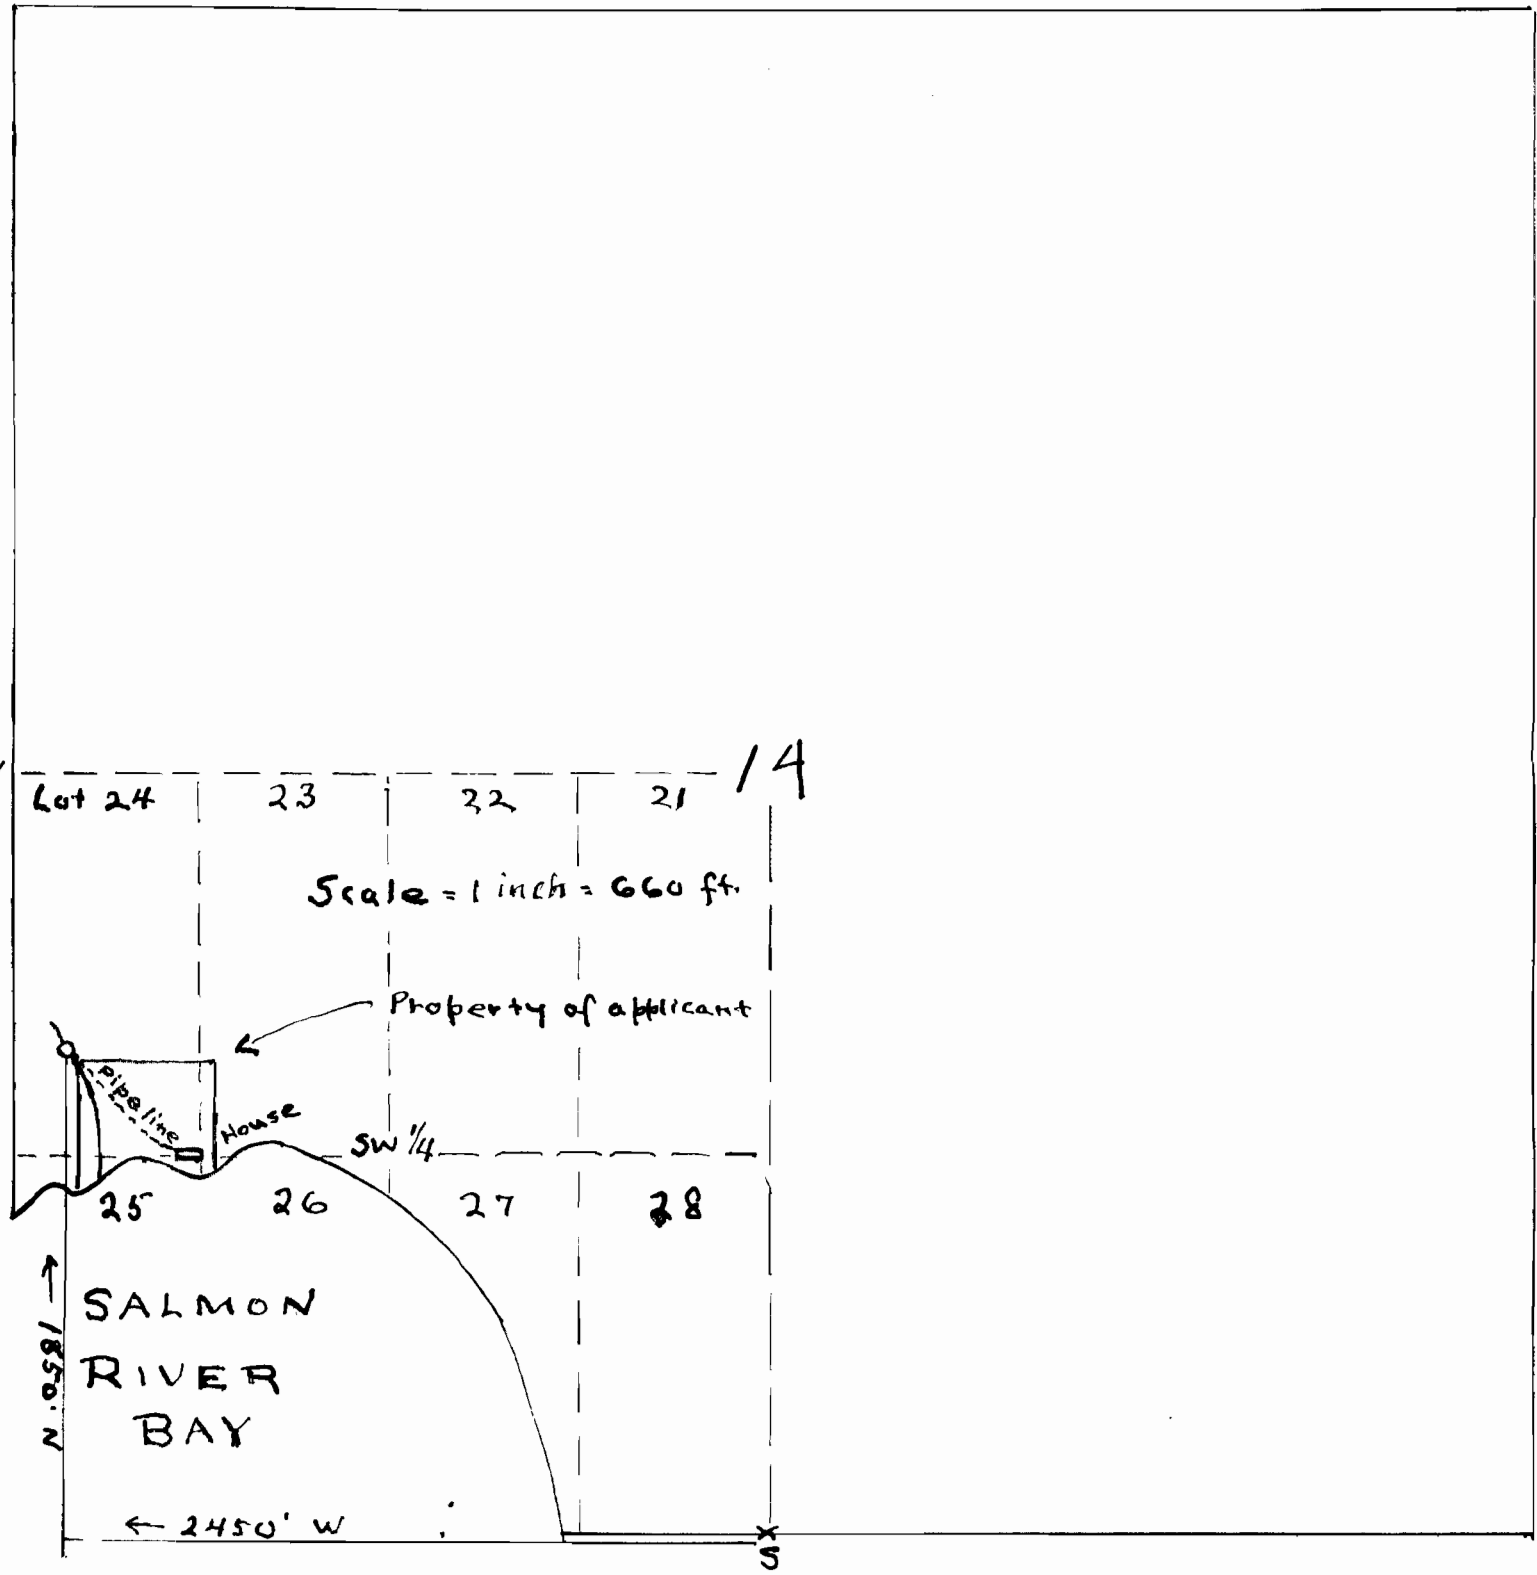

Application No. 14539

Permit No. 10535