


SECTION

- 7
- 8
- 17
- 18

TOWNSHIP 34 S, RANGE 6 W, W. M.

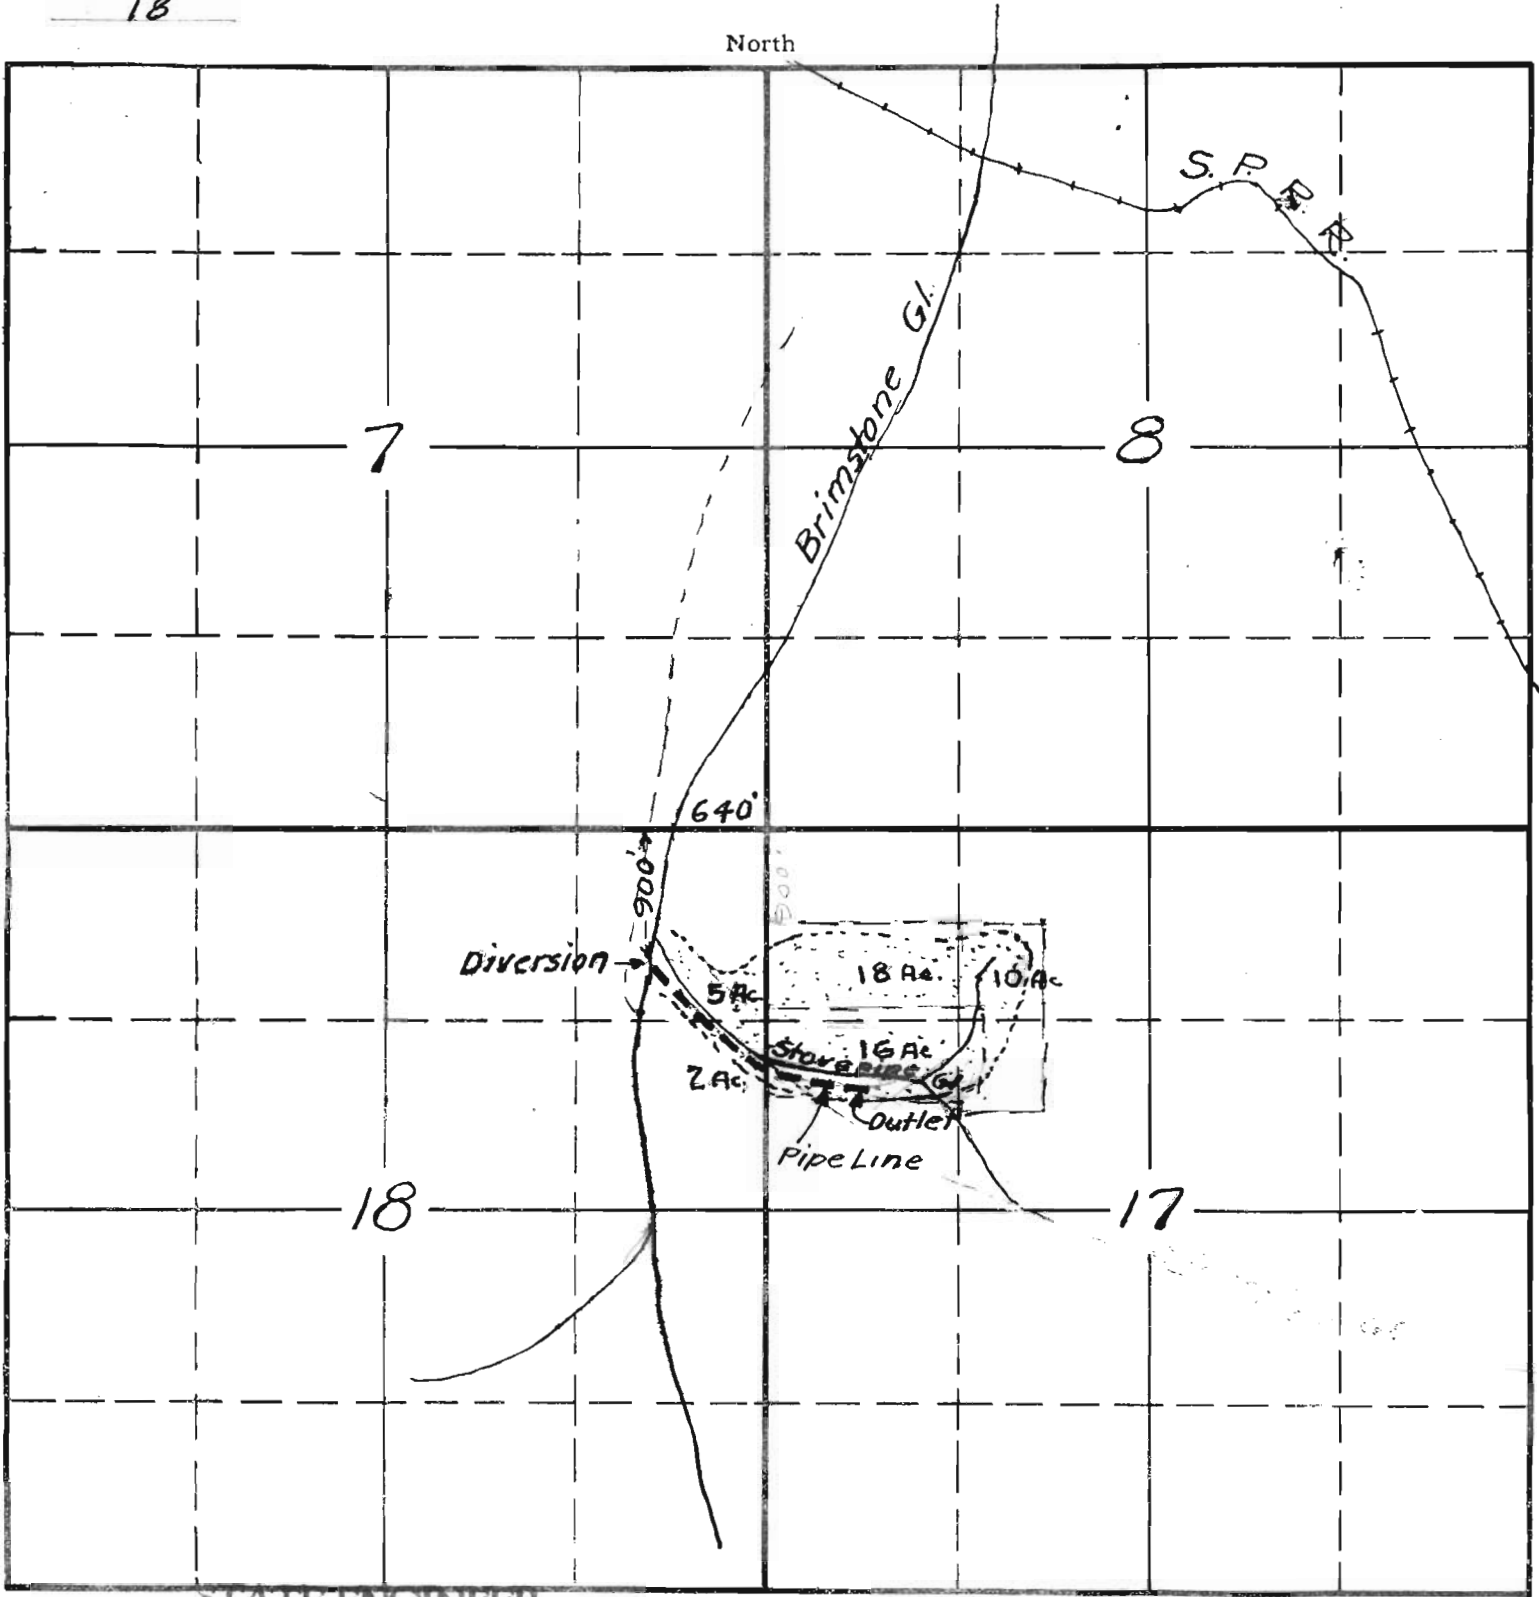

STATE ENGINEER  
 RECEIVED  
 APR 13 1932  
 SALEM, OREGON

APPLICATION No. 14550  
 PERMIT No. 10539