


Township 6 S,

Range 38 E.

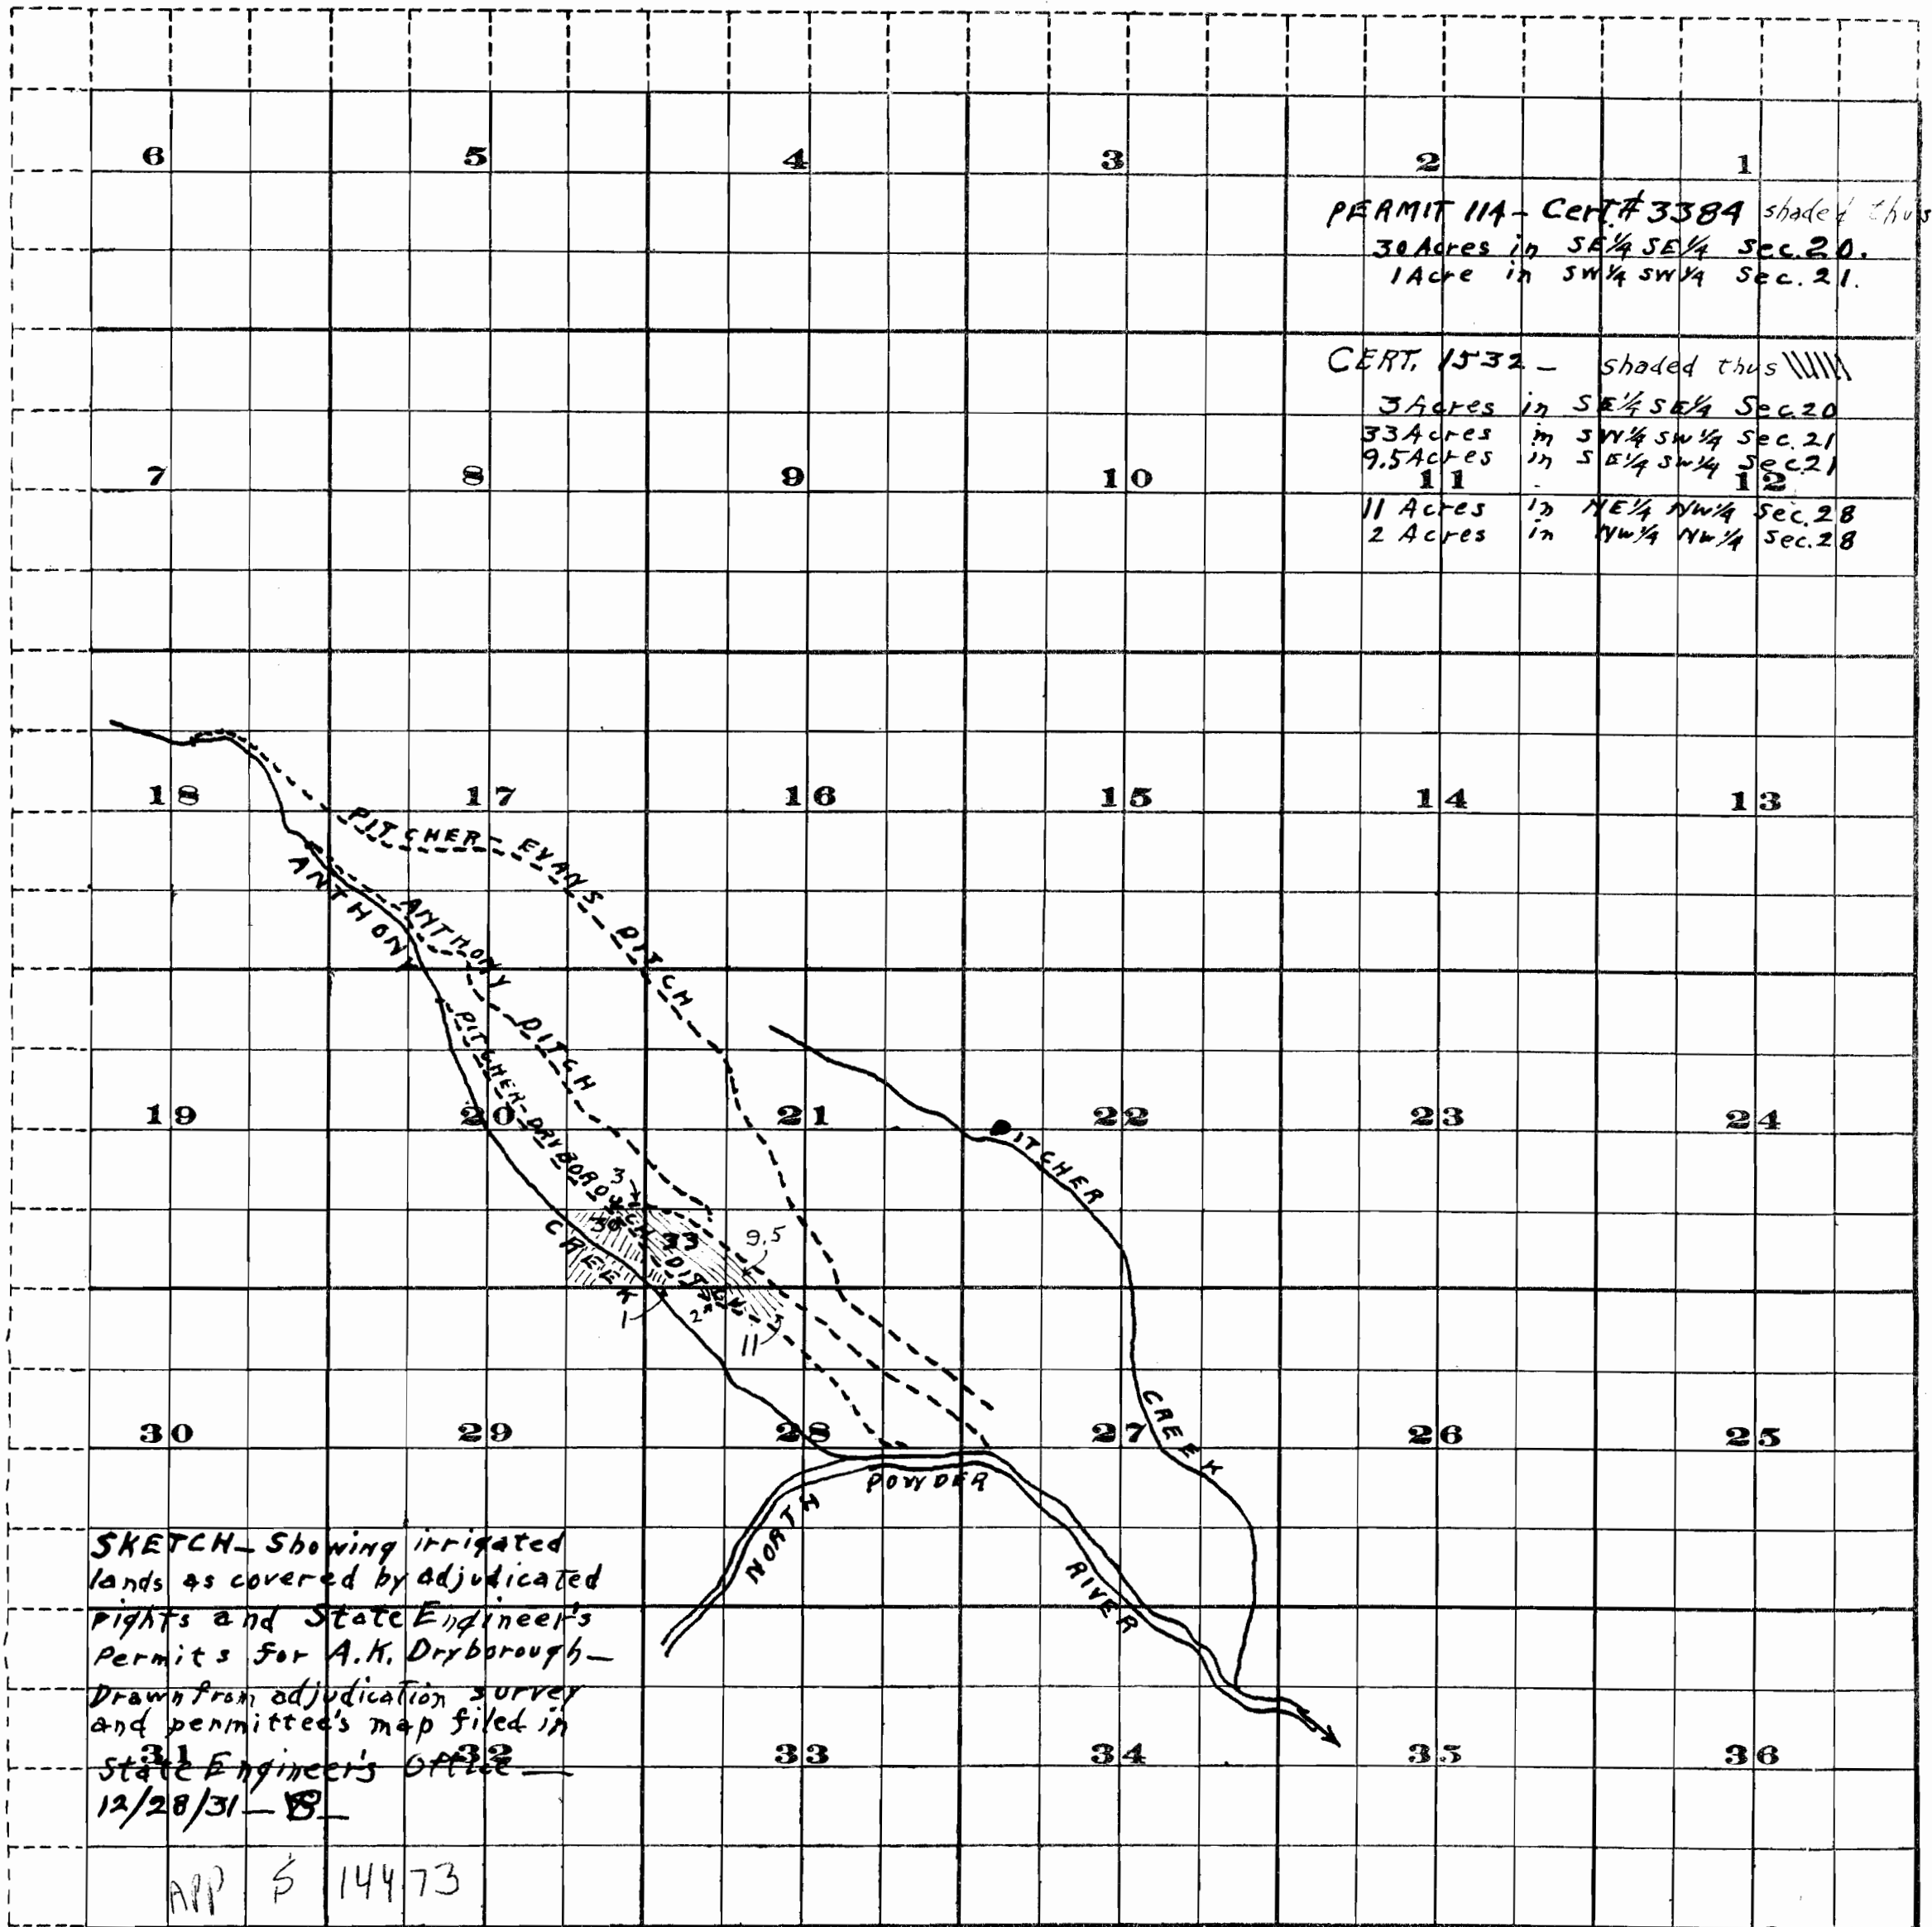

Scale of Feet.

18

Head Gate


19

29

NO. 14473

10551

Ground shaded
thus // to be
irrigated.

