


SECTION

- 23
- 24
- 25
- 26

TOWNSHIP 35 S, RANGE 7 W, W. M.

North

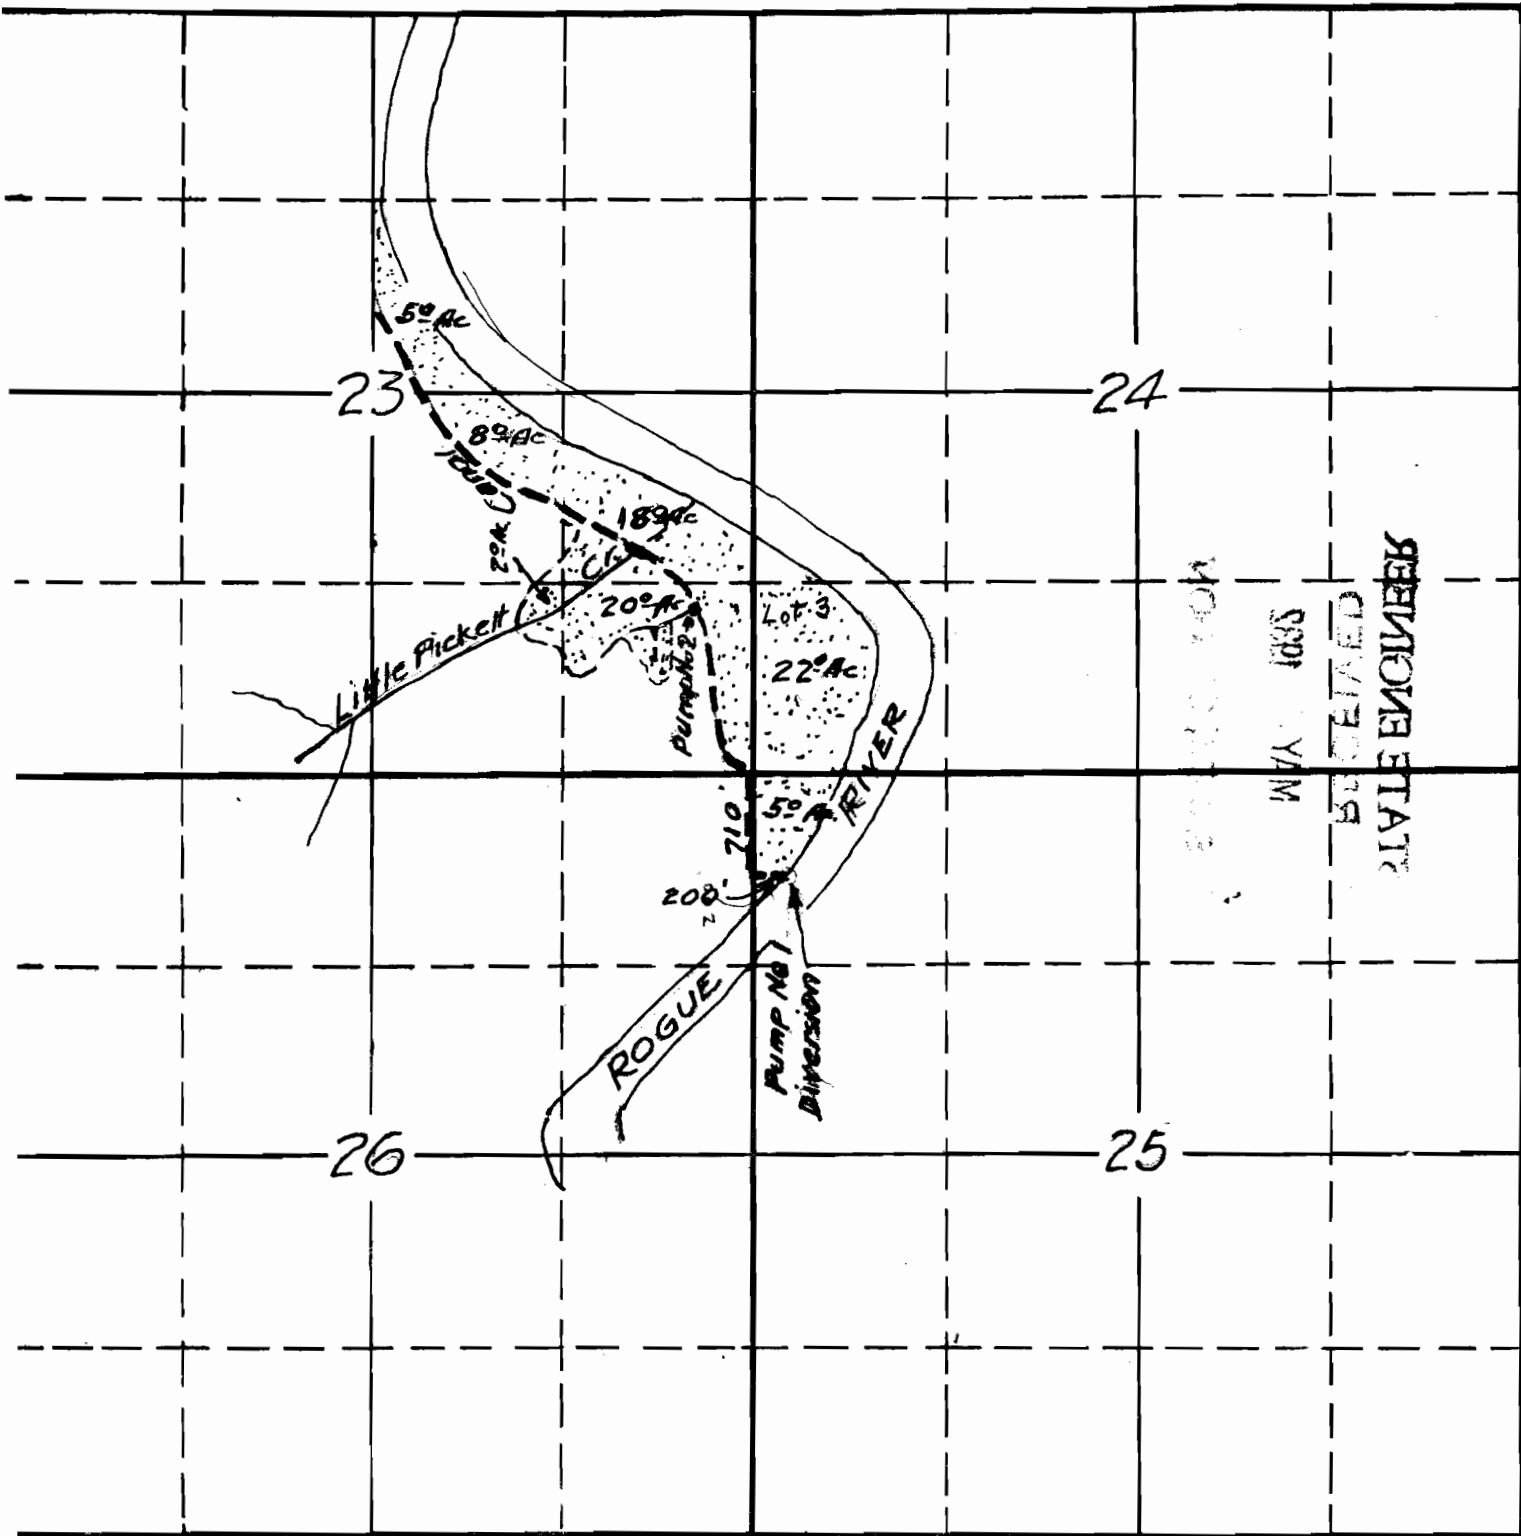

RECEIVED
 STATE ENGINEER
 WYA 1085
 1985

South

APPLICATION No. 14565
 PERMIT No. 10563