

SECTION

34


35

2

3

TOWNSHIP 37 S, RANGE 9 W

Permit: S 10586
Volume: 8
Strm: SIXMILE CR
Trib: ILLINOIS R
Priority: 6/07/32

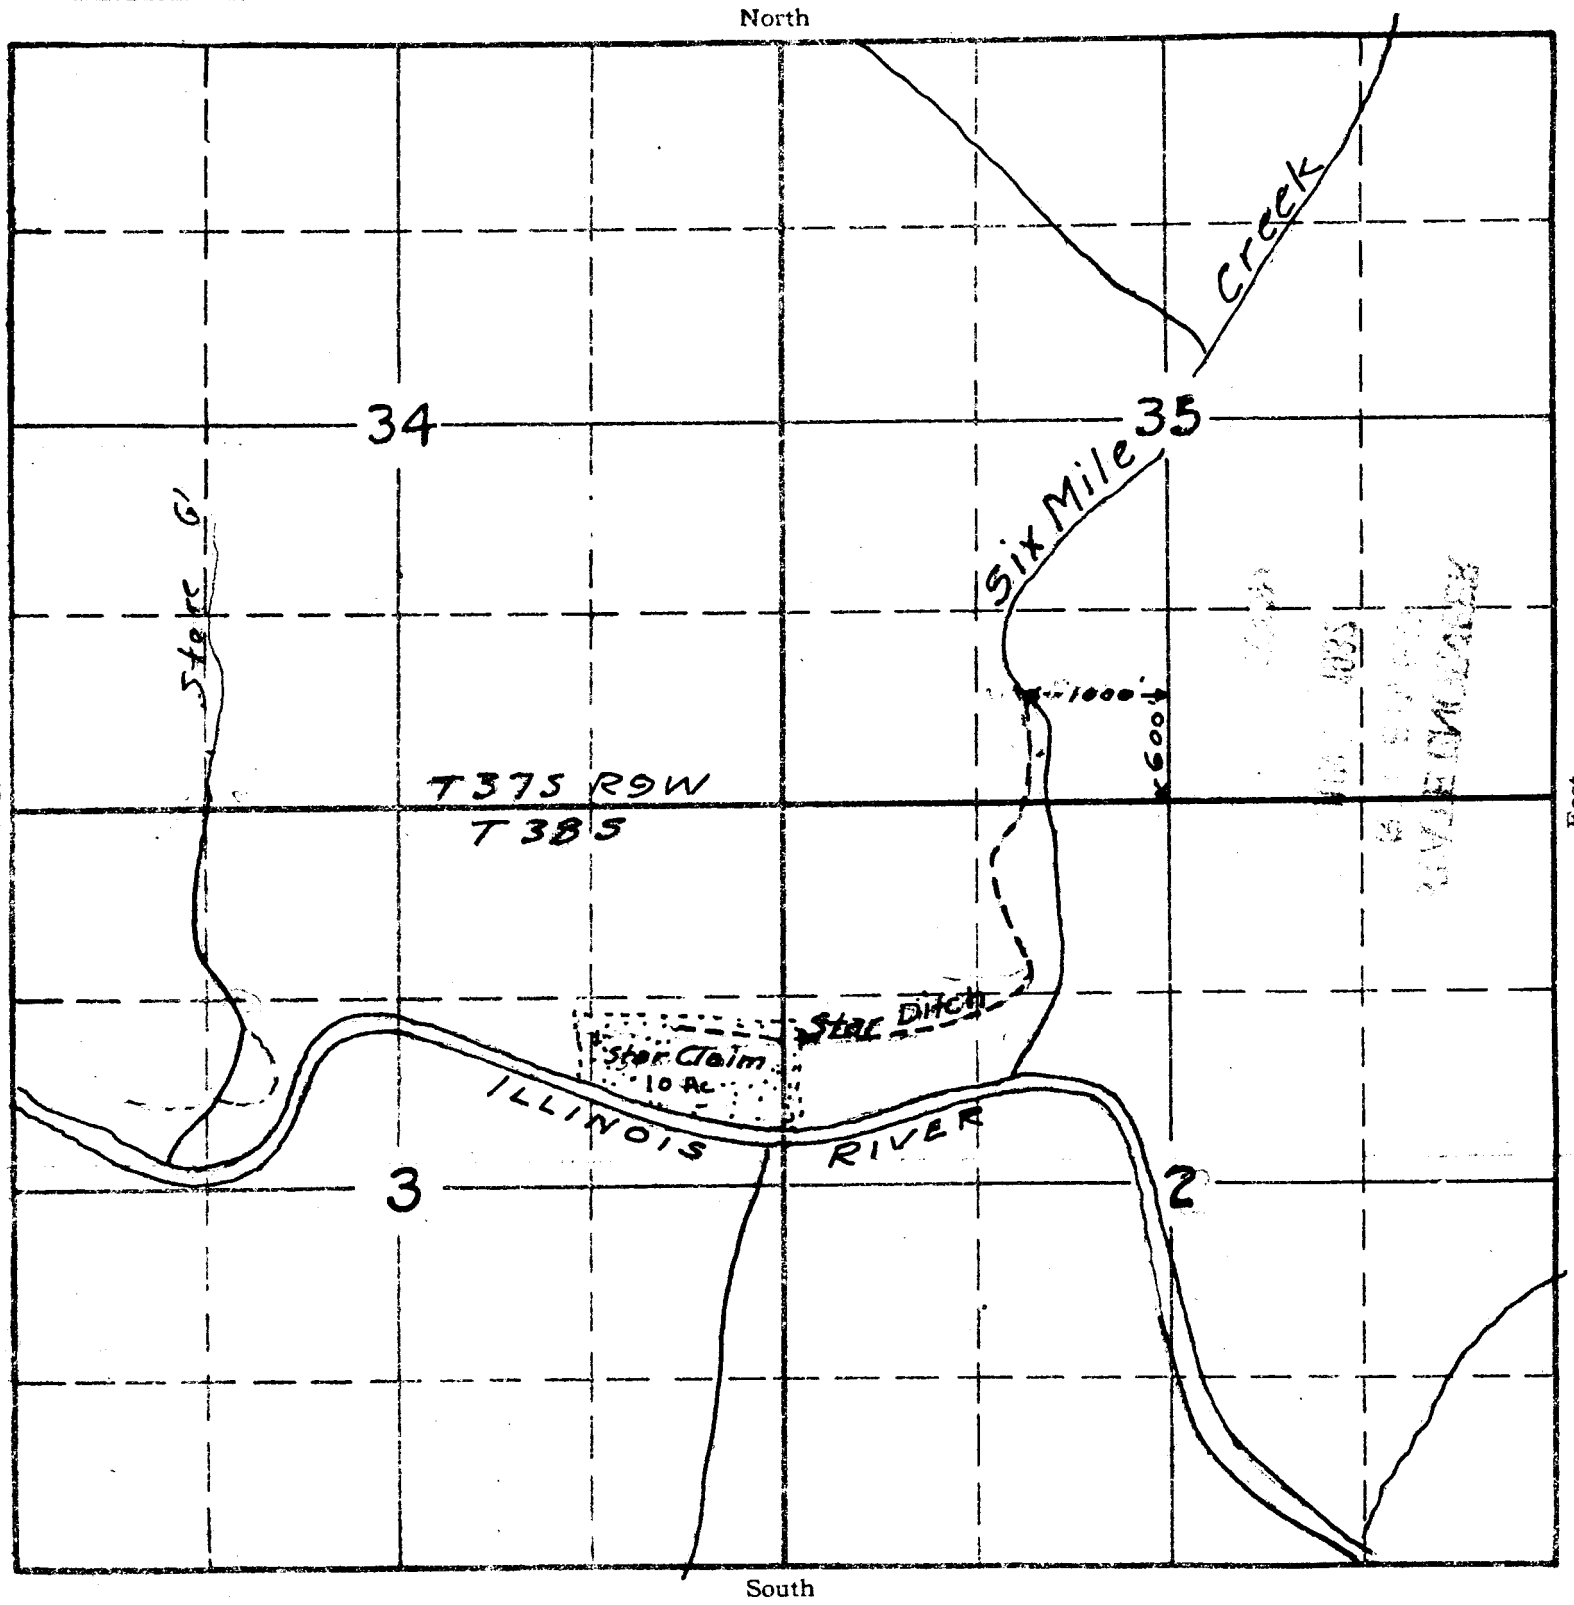

APPLICATION No. 14604
PERMIT No. 10586