


Sec. 27

Tp. 14 S

R. 12 W

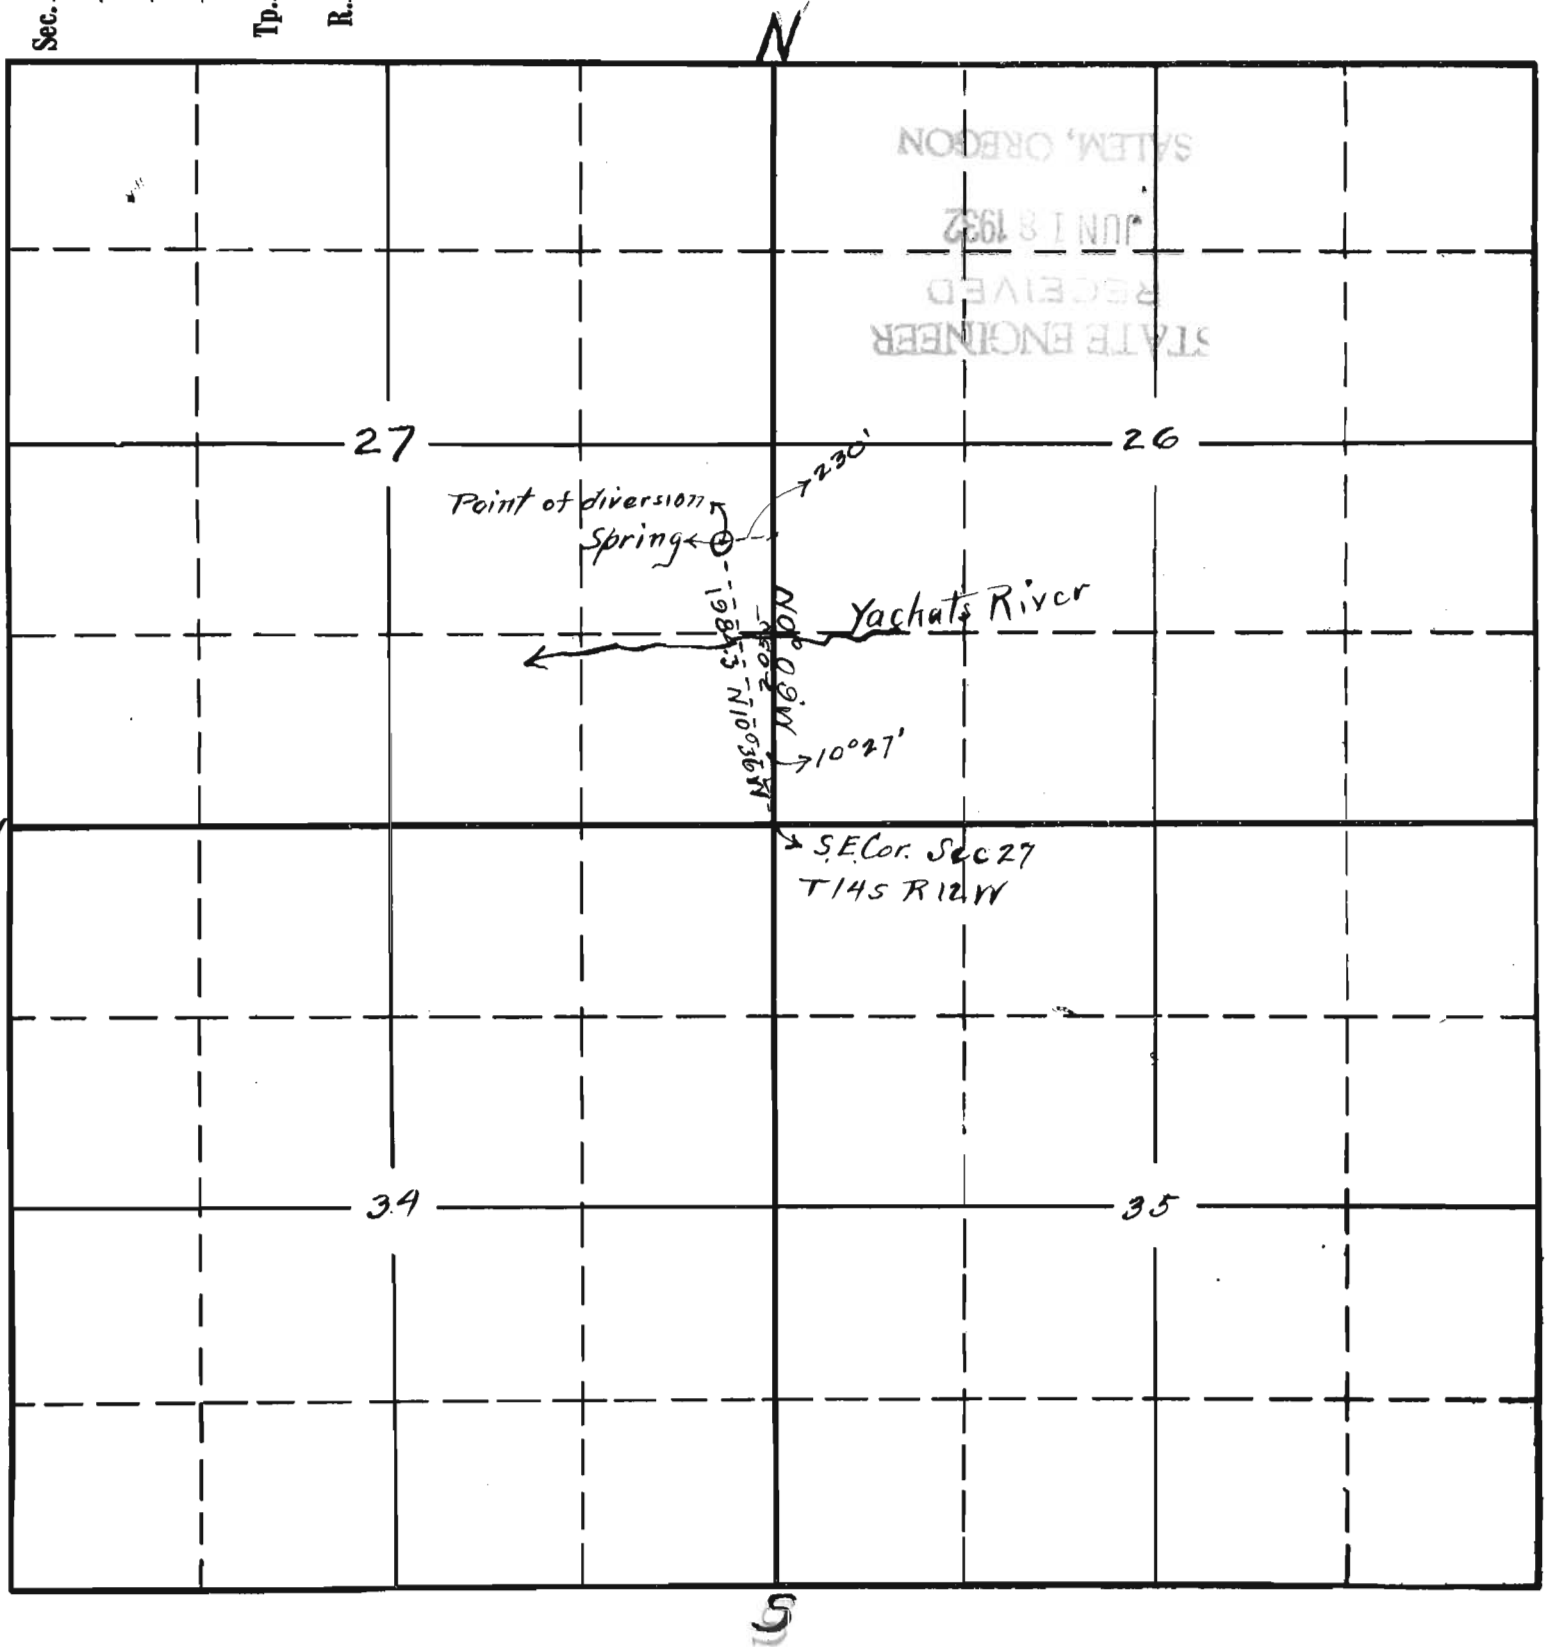

Application No. 14618
Permit No. 10609