


NORTH

Sec 8  
T3SR  
38E07M.

8

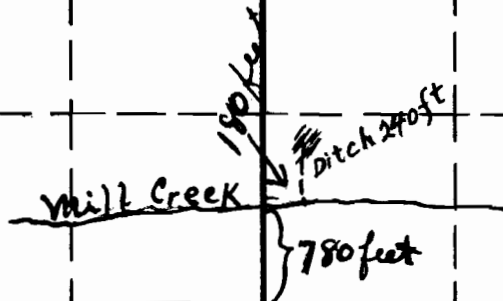

Application No. 14655  
Permit No. 10628

R.

Tp.

Sec.