


SECTION

TOWNSHIP 25, RANGE 4W, W. M.

North

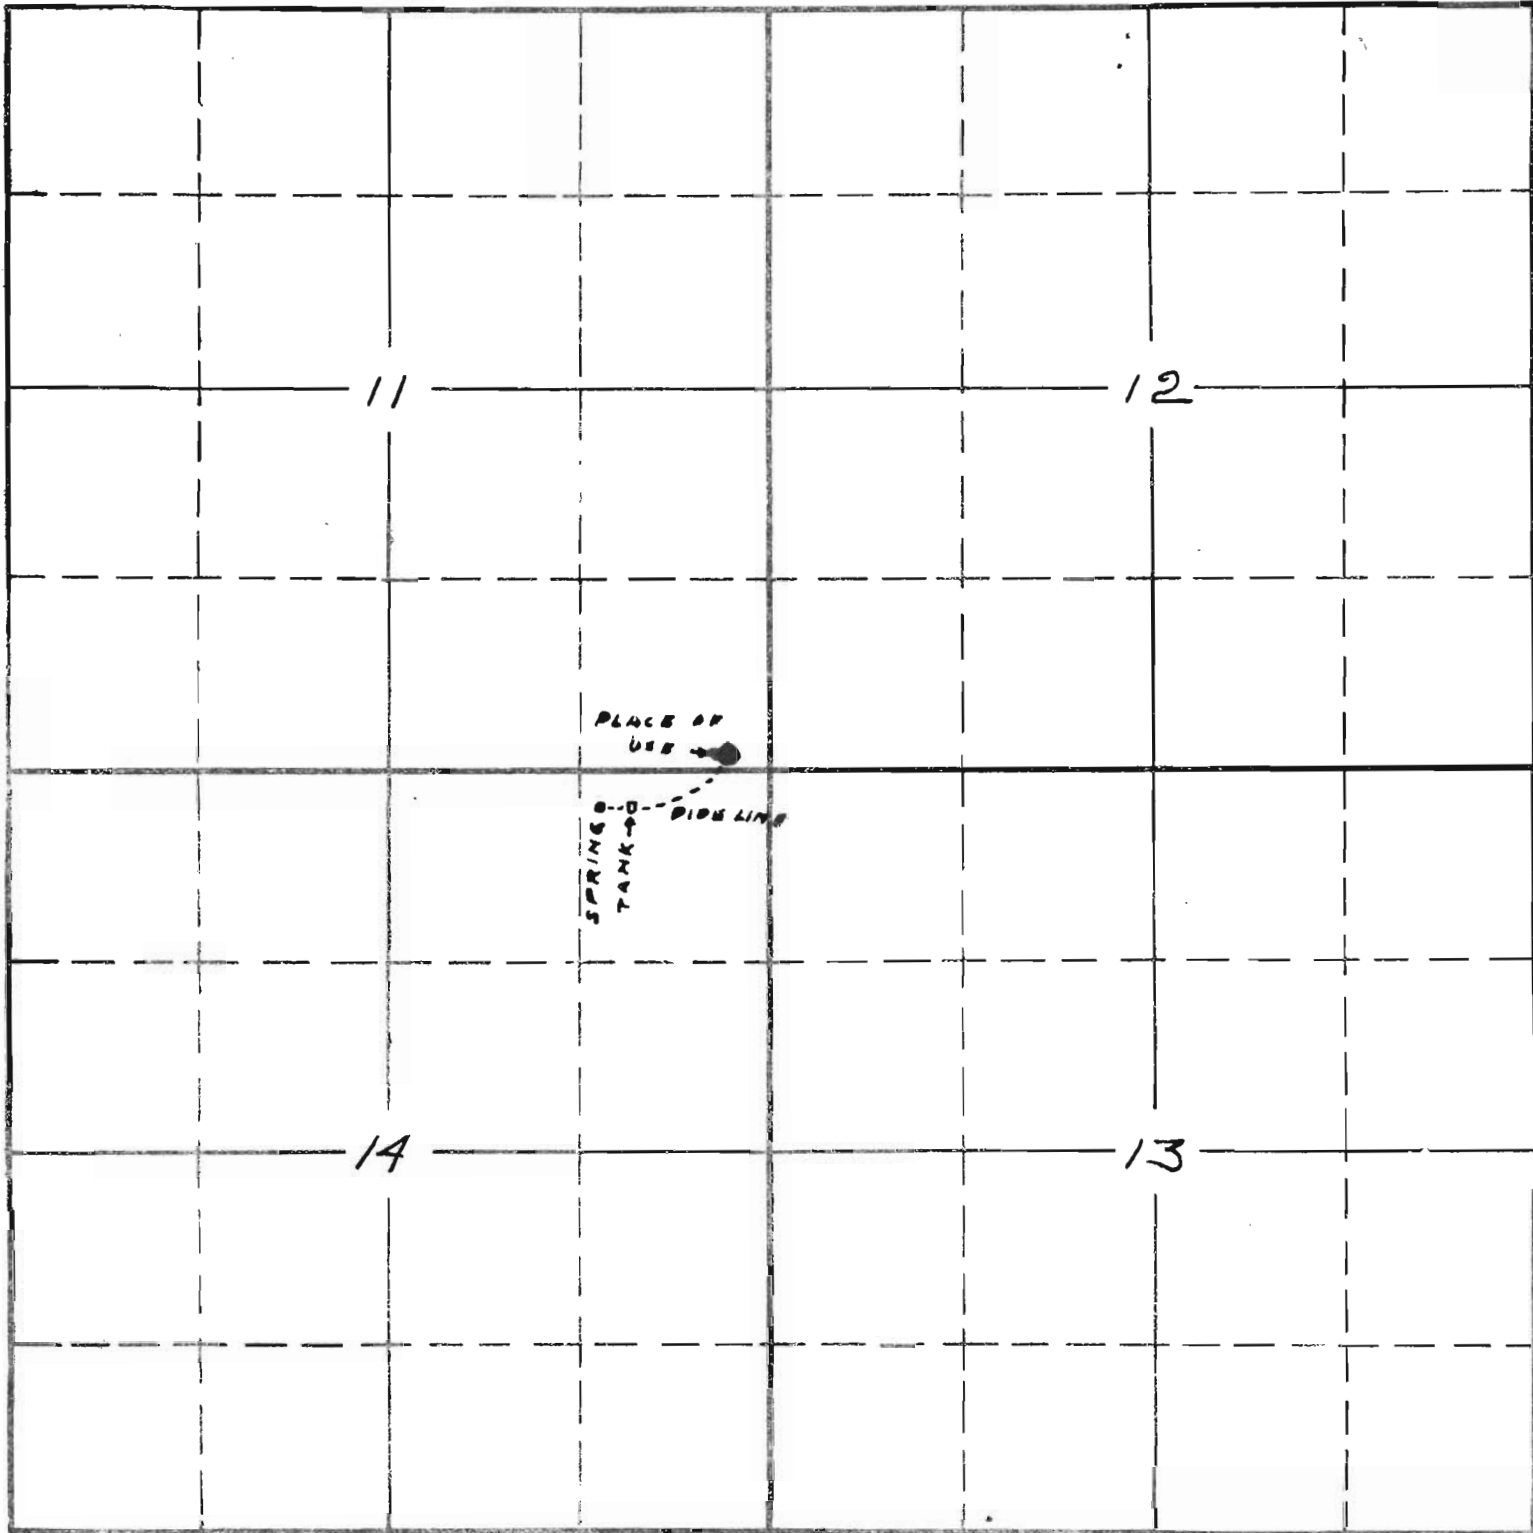

South

APPLICATION No. 14647
PERMIT No. 10644