


SECTION

34

TOWNSHIP 1N , RANGE 4 W , W. M.

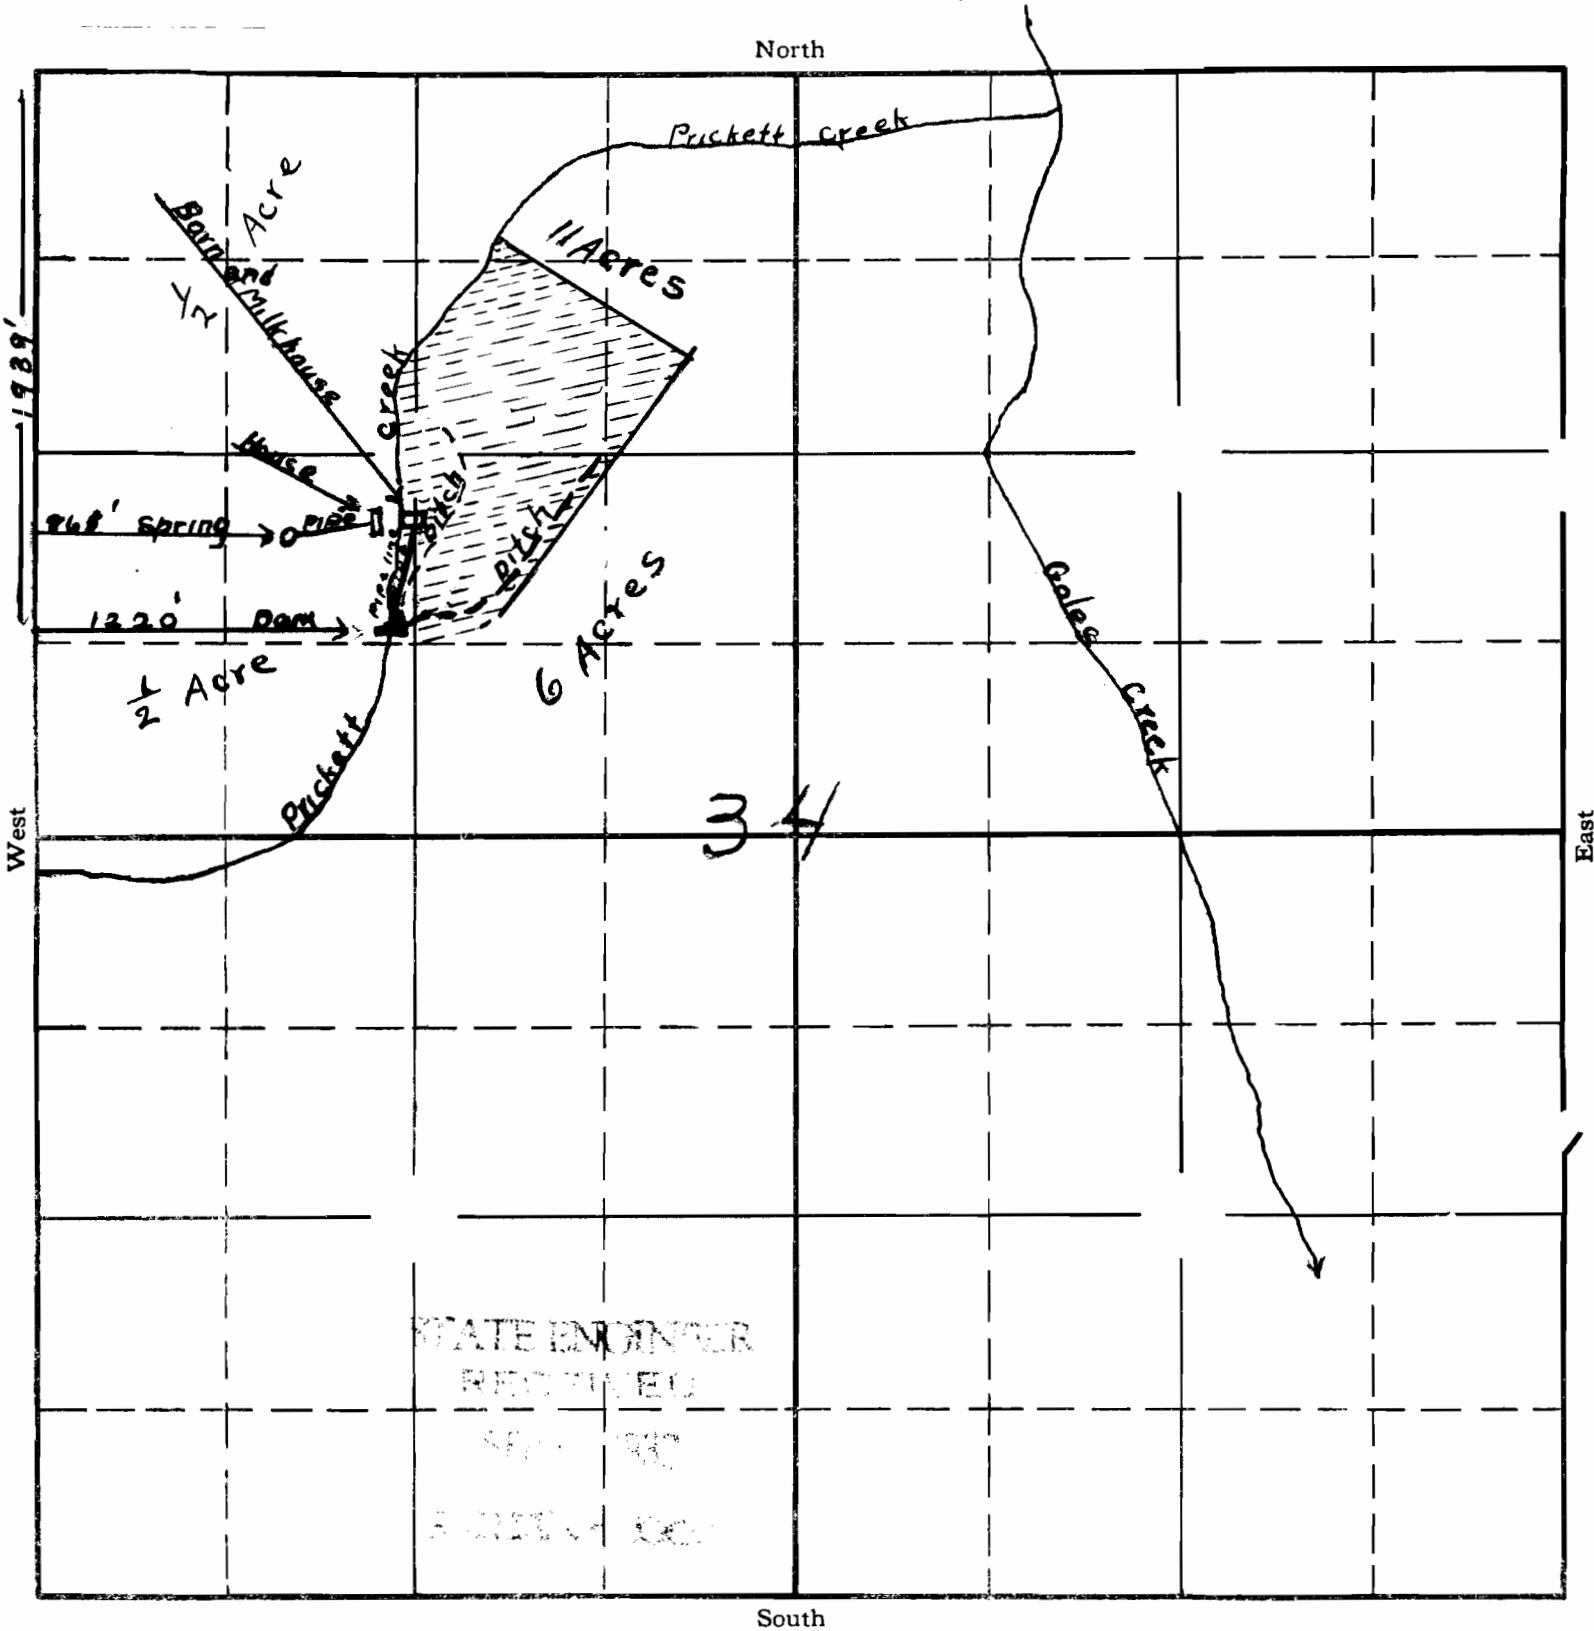

South

Scale 8" = 1 Mile

APPLICATION No. 14713
PERMIT No. 10679