


STATE ENGINEER
RECEIVED
SEP 7 1932
SALEM, OREGON

Application No. 14715
Permit No. 10698

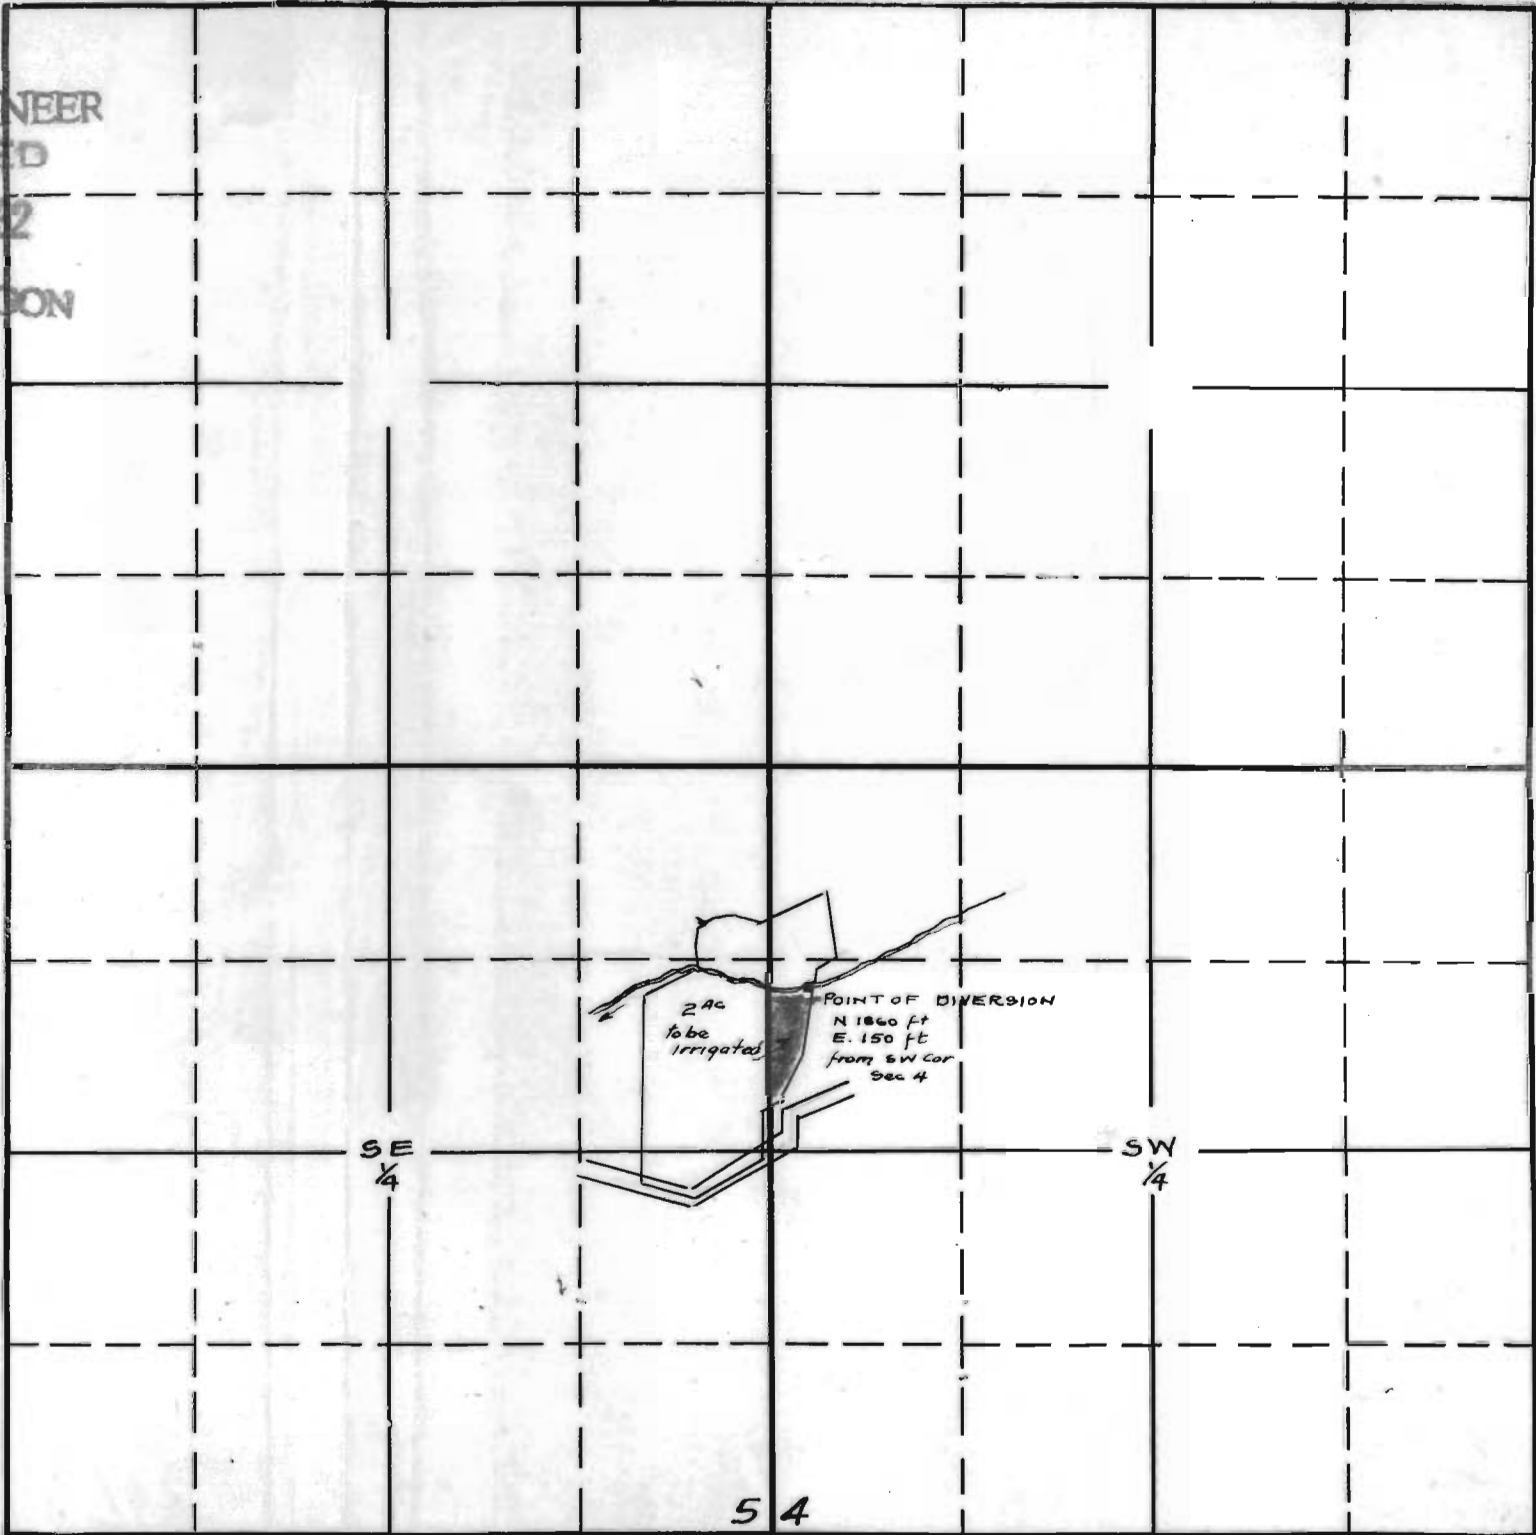

S 4

TP. 2 S.

R. 3 W.

Scale
1" = 10 chs