

SECTION

20


36-6-20

Permit: S 10713
Volume: 7
Strm: THE DRAIN
Trib: THE CANYON
Priority: 10/03/32

Permit: S 10713
Volume: 7
Strm: THE CANYON
Trib: APPLGATE R
Priority: 10/03/32

TO

North

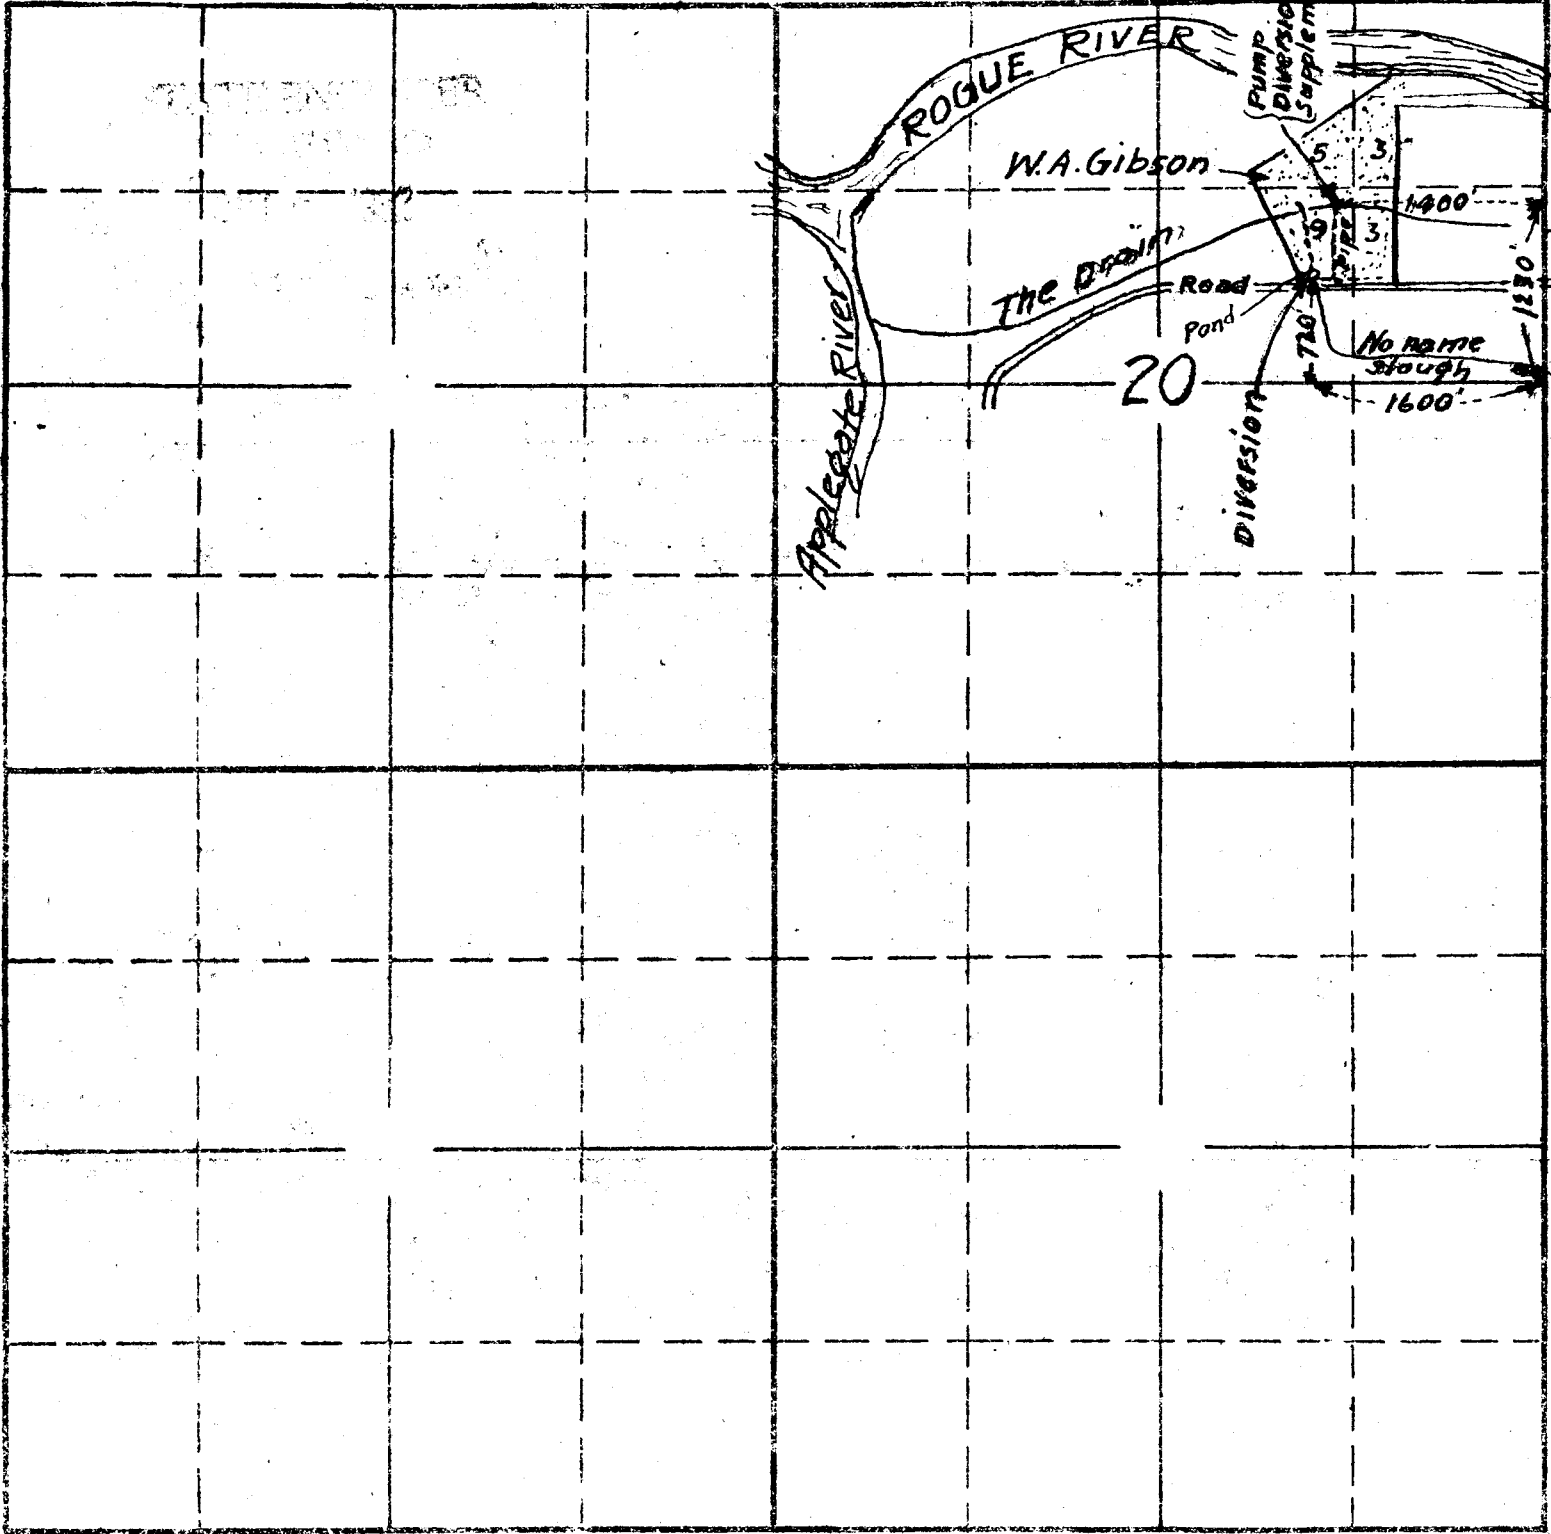

South

14757
APPLICATION No. 14757
PERMIT No. 10713