

Permit: S 10778
Volume: 5B
Strm: TOM EAST CR
Trib: GRAVE CR
Priority: 12/21/32


~~10482~~

L. E. Klumpp

Scale 2"=1 Mile

Nov. 1925

T. 33 S., R. 5 W., W. M.

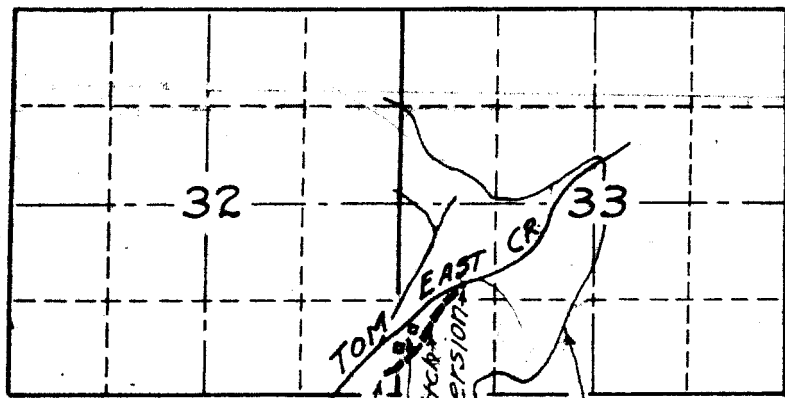

~~10482~~

ENGINEER

Application No. ~~10482~~

14833

Permit No. ~~7037~~

10778