
## township 7.5, range 5.8, w. m.

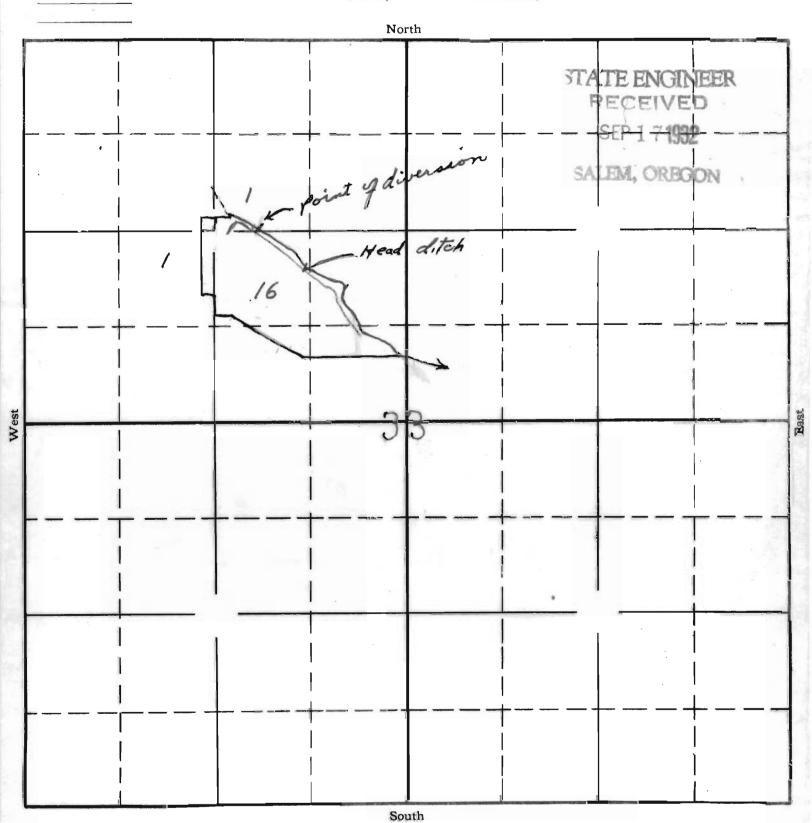

APPLICATION No. 14731 PERMIT No. 10184