

S. 83° 37' W 5251.0'



5 4  
8 9

15 Ac.

Bottom land 52 Ac.

20 Ac.

14 Ac.

9 Ac.

1 Ac.

Sec 15128

Div. Pt.  
moved to here  
in 1933

Never built

PELEG HIBBARD D.L.C.  
IN SECTIONS 4, 5, 8 & 9, T.35. R.5W.  
Scale 1" = 400' Sept. 1930

Application No. 14854  
Permit No. 10816


N 83° 47' E 5249.8'

Traced from photostatic reduction of original map of survey made by Deasley & Foster, Eng'rs, Portland.

SECTION

TOWNSHIP 35, RANGE 5W, W. M.

North

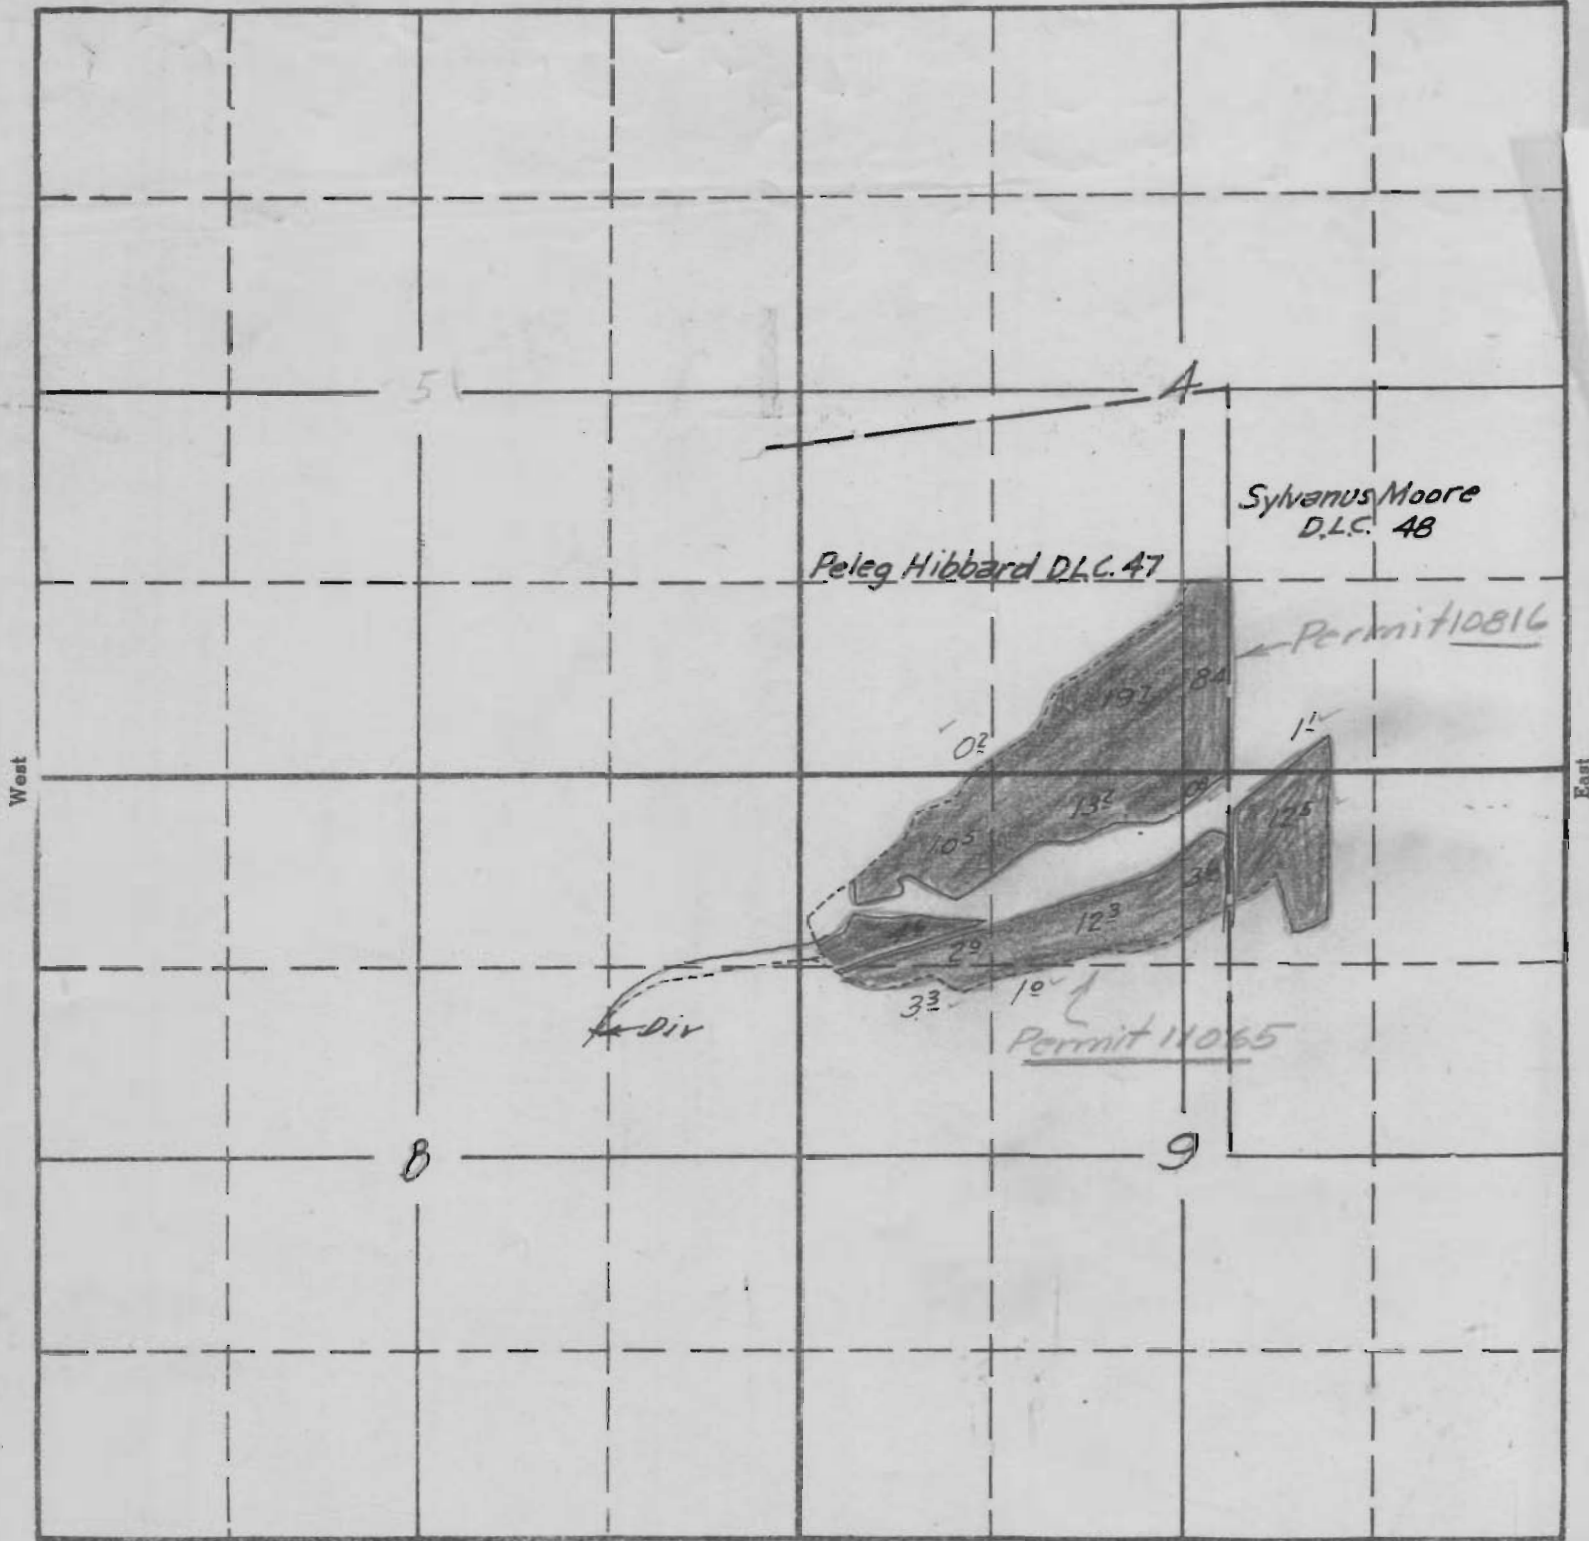

Surveyed June 7 1940 C.C.C.

South

14854  
 APPLICATION No. 15128  
 PERMIT No. 11065  
 10816