


SECTION
14

TOWNSHIP 38 S, RANGE 3 W, W. M.

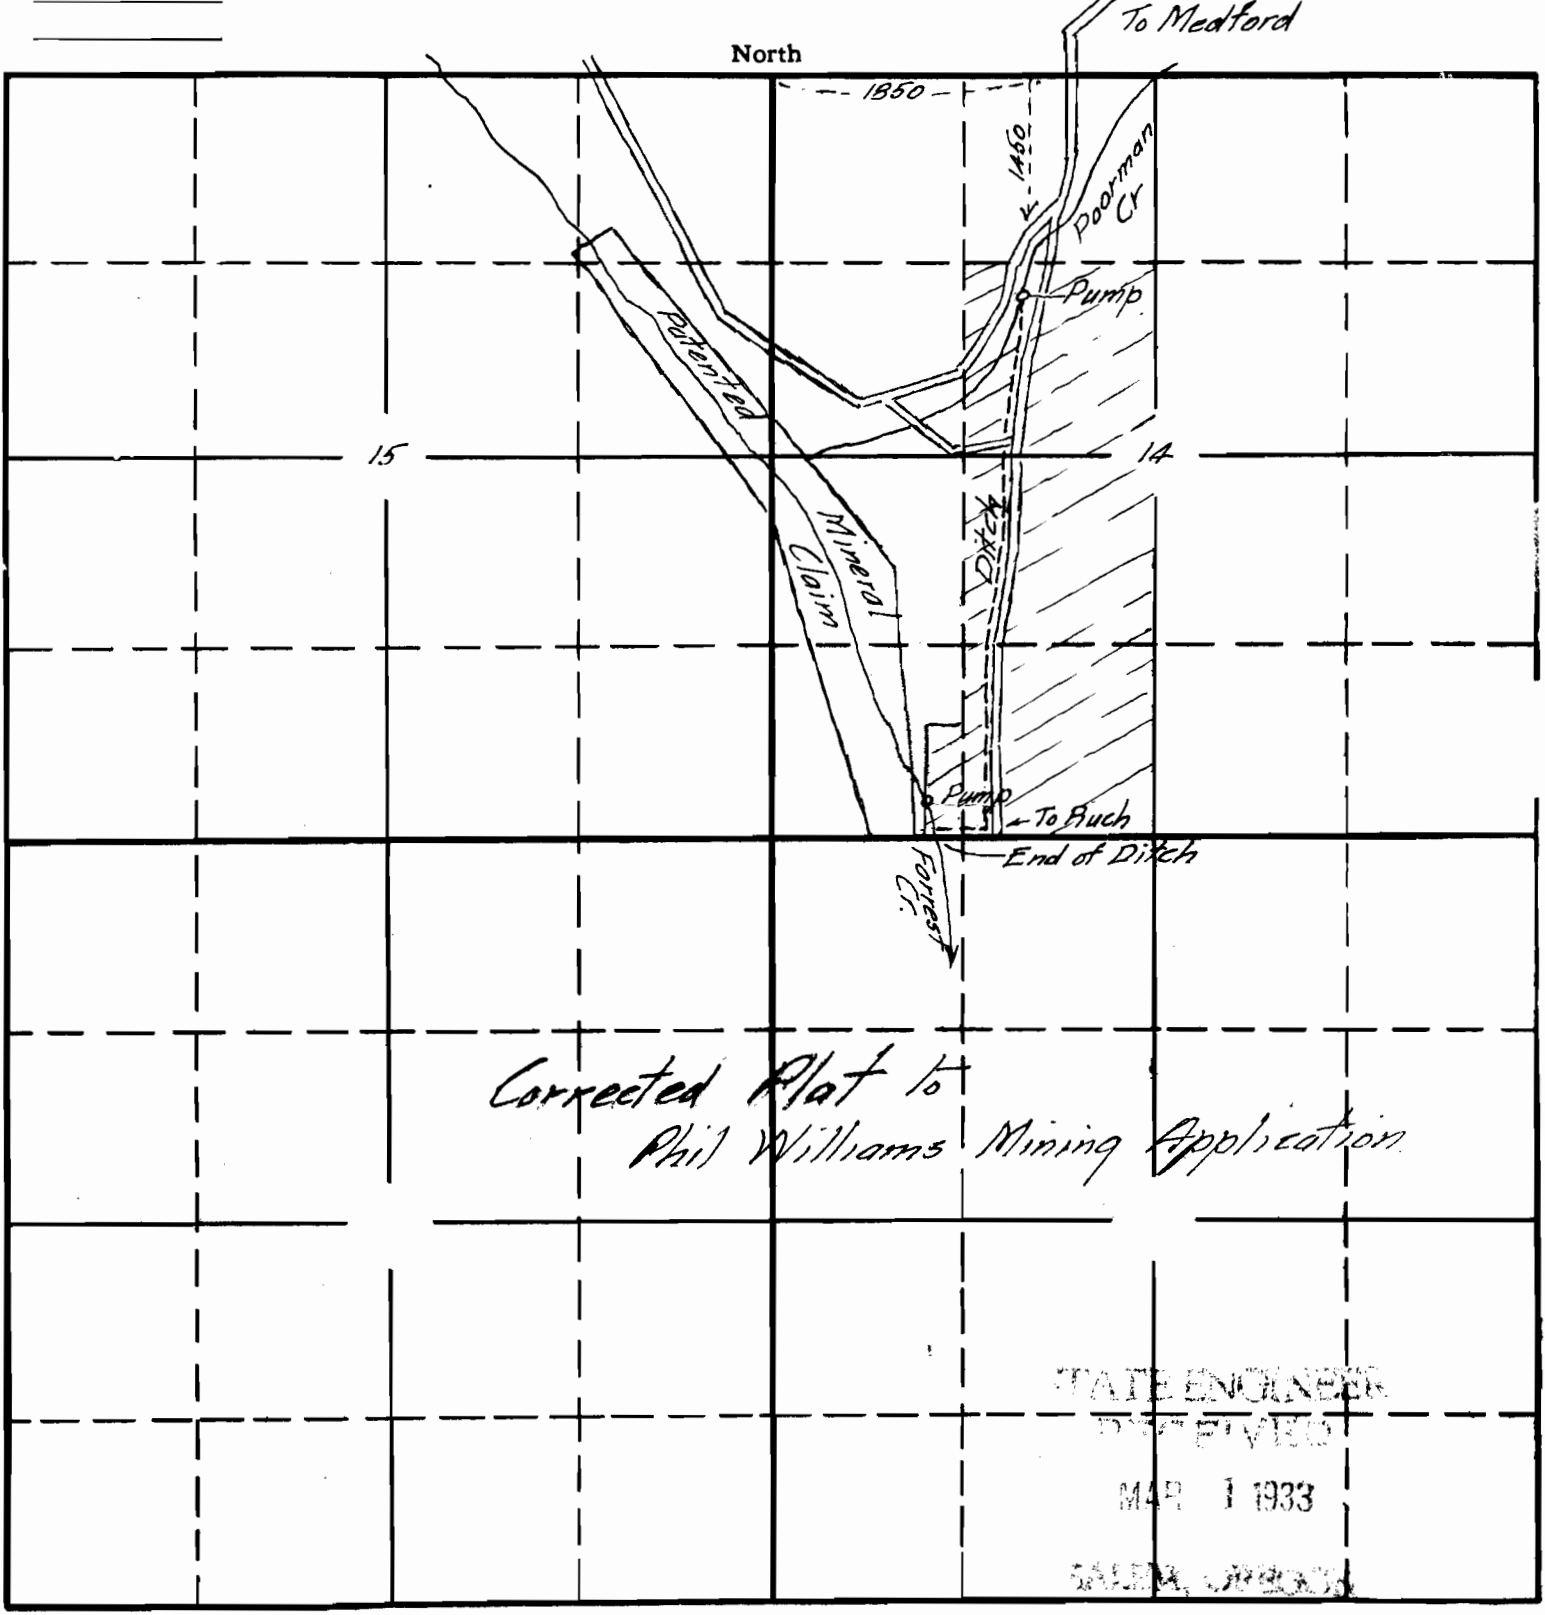

*Corrected Plat to
Phil Williams Mining Application*

STATE ENGINEER
RECEIVED
MAR 1 1933

APPLICATION No. 14561
PERMIT No. 10821